

STATE ENGINEER
Salem, Oregon

LANE
8353

Well Record

STATE WELL NO. 16/LM-35K
COUNTY Lane
APPLICATION NO. GR-3329

OWNER: M. J. Kulick

MAILING ADDRESS: 415 Beacon Drive.


LOCATION OF WELL: Owner's No.

CITY AND STATE: Eugene, Oregon

NW ¼ SE ¼ Sec. 35 T. 16 N. S. R. 4 E. W., W.M.

Bearing and distance from section or subdivision

corner 109' S. 187' E. SE Cor. Howard Maupin DLC

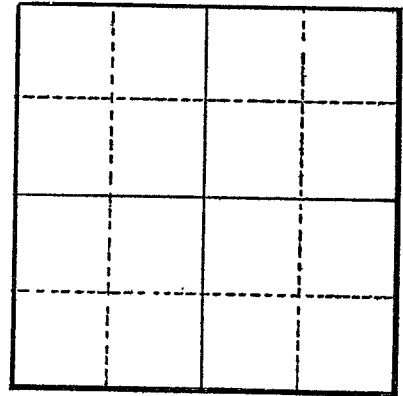

Section

Altitude at well

TYPE OF WELL: driven Date Constructed 1949

Depth drilled 21' Depth cased 21'

CASING RECORD:

3"

FINISH:

54 - 7/16" Holes from 19 to 21

AQUIFERS:

dirt, gravel

WATER LEVEL:

11'

PUMPING EQUIPMENT: Type Jacuzzi Cent.

H.P. 1

Capacity 1700 G.P.M. H

WELL TESTS:

Drawdown ft. after hours G.P.M.

Drawdown ft. after hours G.P.M.

USE OF WATER Irrigation

Temp. °F. 19

SOURCE OF INFORMATION GR-3087

DRILLER or DIGGER M. J. Kulick

ADDITIONAL DATA:

Log Water Level Measurements Chemical Analysis Aquifer Test

REMARKS:

Dirt 11 21
gravel 10