

STATE ENGINEER
Salem, Oregon

LANE
8354

Well Record

STATE WELL NO. 16/LW-35L
COUNTY Lane
APPLICATION NO. GR-3901

OWNER: Evodia Haterius


MAILING ADDRESS: 200 Beacon Drive

LOCATION OF WELL: Owner's No. _____

CITY AND STATE: Eugene, Oregon

NE 1/4 SW 1/4 Sec. 35 T. 16 S., R. 4 W., W.M.

Bearing and distance from section or subdivision corner From NE Cor. of James Watson donation land claim No. 41, 236 feet North; 204 feet West, 189 feet South to well

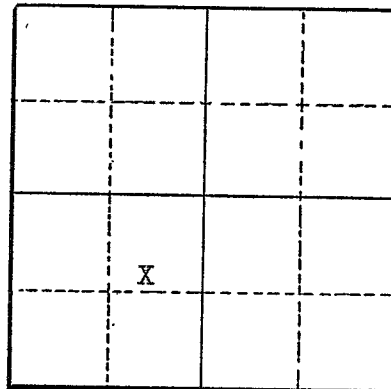

Section 35

Altitude at well _____

TYPE OF WELL: Drilled Date Constructed 1948

Depth drilled 21 feet Depth cased _____

CASING RECORD:

FINISH:

AQUIFERS:

WATER LEVEL:
12 feet below surface

PUMPING EQUIPMENT: Type (Motor) Fairbanks Morse H.P. 5
Capacity 200 G.P.M.

WELL TESTS:

Drawdown _____ ft. after _____ hours _____ G.P.M.
Drawdown _____ ft. after _____ hours _____ G.P.M.

USE OF WATER Irrigation Temp. _____ °F. _____, 19____

SOURCE OF INFORMATION Well Registration Statement Cert. # GR-3544

DRILLER or DIGGER _____

ADDITIONAL DATA:

Log _____ Water Level Measurements _____ Chemical Analysis _____ Aquifer Test _____

REMARKS: