

**LANE**  
**8355**

# Well Record

STATE WELL NO. 16/LW-351  
COUNTY Lane  
APPLICATION NO. CR-3535

OWNER: Evodia Haterius

MAILING

ADDRESS: 200 Beacon Drive

CITY AND

STATE: Eugene, Oregon

LOCATION OF WELL: Owner's No.


Well # 1:

NE 1/4 SW 1/4 Sec. 35 T. 16 S. R. 4 W., W.M.

Bearing and distance from section or subdivision

corner 168 ft. West, 168 feet south, 21 ft. East

from NE corner of Jos. Waters D.L.C.

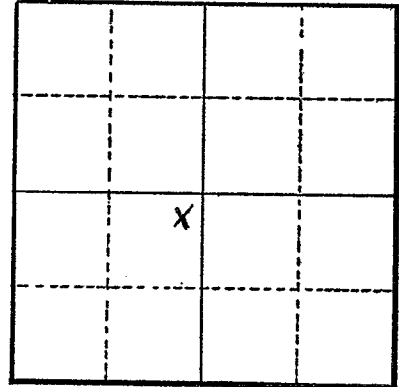

Section 35

Altitude at well

TYPE OF WELL: Drilled Date Constructed 1900

Depth drilled 21 ft. Depth cased 21 ft.

### CASING RECORD:

4 inch casing set to 21 feet.

### FINISH:

perforations cut from 13 ft. to 21 ft.

### AQUIFERS:

Gravel

### WATER LEVEL:

8 feet below surface

PUMPING EQUIPMENT: Type Ingersol, Rand Centrifugal H.P. 2 1/2  
Capacity 100 G.P.M.

### WELL TESTS:

Drawdown ft. after hours G.P.M.

Drawdown ft. after hours G.P.M.

USE OF WATER irrigation Temp. °F. 19

SOURCE OF INFORMATION Well Registration Statement

DRILLER or DIGGER

### ADDITIONAL DATA:

Log  Water Level Measurements Chemical Analysis Aquifer Test

### REMARKS:

Log: Top Soil  
Gravel

Thickness	Depth to Bottom
3	21
18	21