

STATE ENGINEER
Salem, Oregon

LANE
8374

Well Record

GR-944

STATE WELL NO. 16/4W-36B(1)
COUNTY Lane
APPLICATION NO. GR-974

OWNER: Green Brothers

MAILING

ADDRESS: Box 72

LOCATION OF WELL: Owner's No. #2


CITY AND

STATE: Coburg, Oregon

NW 1/4 NE 1/4 Sec. 36 T. 16 S., R. 4 W., W.M.

Bearing and distance from section or subdivision

corner S. 23° 01' W. 345.8' from the E. 1/4 cor. Sec. 25.

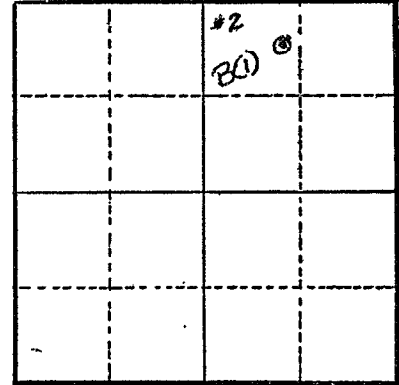

Section 36

Altitude at well 368 ft.

TYPE OF WELL: Dug Date Constructed 1954

Depth drilled 18 ft. Depth cased 18 ft.

CASING RECORD:

Open hole	0 to 6 ft.
30 in. concrete	6 to 18 ft.

FINISH:

AQUIFERS:

WATER LEVEL:

12 ft.

PUMPING EQUIPMENT: Type 4" x 3" Centrifugal H.P. 20

Capacity 400 G.P.M.

WELL TESTS:

Drawdown 3 ft. after _____ hours 400 G.P.M.

Drawdown _____ ft. after _____ hours _____ G.P.M.

USE OF WATER Irrigation Temp. _____ °F., 19

SOURCE OF INFORMATION G.R. Record

DRILLER or DIGGER

ADDITIONAL DATA:

Log _____ Water Level Measurements _____ Chemical Analysis _____ Aquifer Test _____

REMARKS:

Log: Medium sized gravel	0 to 16 ft.
Pea gravel	16 to 18 ft.

Irrigation of 44 acres.