

STATE ENGINEER
Salem, Oregon

LANE
8376 Well Record

STATE WELL NO. 16/4W-36H(1)
COUNTY Lane
APPLICATION NO. GR-973

GR-943

OWNER: Green Brothers


MAILING ADDRESS: Box 72

LOCATION OF WELL: Owner's No. #1

CITY AND STATE: Coburg, Oregon

SE 1/4 NE 1/4 Sec. 36 T. 16 S., R. 4 W., W.M.

Bearing and distance from section or subdivision corner S11°38'W, 4636' from the E 1/4 cor. Sec. 25.

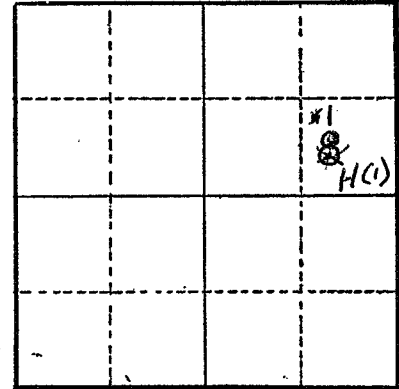

Section 36

Altitude at well 368 ft.

TYPE OF WELL: Dug Date Constructed 1951

Depth drilled 8 ft. Depth cased 8 ft.

CASING RECORD:

24 inch galvanized culvert.

FINISH:

AQUIFERS:

WATER LEVEL:

3 ft.

PUMPING EQUIPMENT: Type 4" x 3" Centrifugal H.P. 20
Capacity 400 G.P.M.

WELL TESTS:

Drawdown 2 ft. after 800 hours G.P.M.
Drawdown ft. after hours G.P.M.

USE OF WATER Irrigation Temp. °F., 19

SOURCE OF INFORMATION G.R. Record

DRILLER or DIGGER

ADDITIONAL DATA:

Log Water Level Measurements Chemical Analysis Aquifer Test

REMARKS:

Log: Medium sized gravel 0 to 6 ft.
Pea gravel 6 to 8 ft.

Irrigation of 22 acres.