

STATE ENGINEER
Salem, Oregon

LANE Well Record
8377


STATE WELL NO. 16/4W-36M(1)
COUNTY Lane
APPLICATION NO. GR-784

OWNER: Alfred W. Jones MAILING ADDRESS:

LOCATION OF WELL: Owner's No. #1 CITY AND STATE: Eugene, Oregon

NW 1/4 SW 1/4 Sec. 36 T. 16 S., R. 4 W., W.M.

Bearing and distance from section or subdivision corner 2035' S5°40'W from the John Brown DLC #44

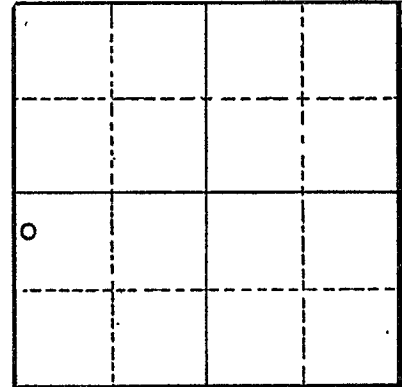

Section 36

Altitude at well 370 feet

TYPE OF WELL: Drilled Date Constructed May 1952

Depth drilled 22 ft. Depth cased 23 ft.

CASING RECORD:
4 in. from 0 to 23 feet

FINISH:
#10 inch screen from 20 to 22 ft.

AQUIFERS:

WATER LEVEL:
13 feet

PUMPING EQUIPMENT: Type Elect. - Wyss 2 1/2 in. H.P. 5
Capacity 180 G.P.M.

WELL TESTS:
Drawdown 2 ft. after 180 hours G.P.M.
Drawdown ft. after hours G.P.M.

USE OF WATER Irrigation Temp. °F. 19

SOURCE OF INFORMATION GR-784

DRILLER or DIGGER

ADDITIONAL DATA:
Log None Water Level Measurements Chemical Analysis Aquifer Test

REMARKS: