

STATE ENGINEER
Salem, Oregon

LANE
8378


Well Record

STATE WELL NO. 16/4W-36N
COUNTY Lane
APPLICATION NO. GR-3622

OWNER: Page Walton
MAILING ADDRESS: 1225 Beacon Drive
CITY AND STATE: Eugene, Oregon

LOCATION OF WELL: Owner's No. M. R. W.M.
SW 1/4 SW 1/4 Sec. 36 T. 16 S., R. 4 W., W.M.

Bearing and distance from section or subdivision
corner From SW corner Sec. 36 710' N. 33° E. to well

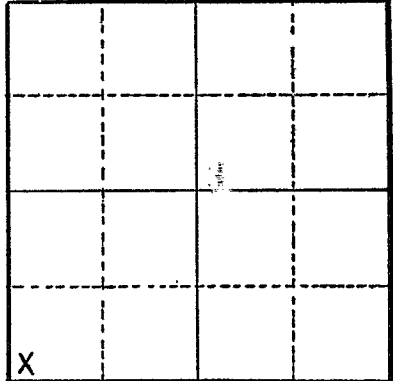

Section 36

Altitude at well

TYPE OF WELL: Driven Date Constructed Mar. 1953

Depth drilled 26 feet Depth cased 21 ft.

CASING RECORD:

6 inch casing set to 21 feet

FINISH:

42 5/16" diameter holes per foot from 4 feet to 21 feet

AQUIFERS:

WATER LEVEL:

9 feet below surface

PUMPING EQUIPMENT: Type Fairbanks Morse centrifugal H.P. 7 1/2
Capacity 150 G.P.M.

WELL TESTS:

Drawdown 1" ft. after 150 hours G.P.M.
Drawdown ft. after hours G.P.M.

USE OF WATER Irrigation Temp. °F. 19

SOURCE OF INFORMATION Well Registration Statement

DRILLER or DIGGER D. D. Dickinson

ADDITIONAL DATA:

Log Water Level Measurements Chemical Analysis Aquifer Test

REMARKS: