

STATE ENGINEER
Salem, Oregon

LANE Well Record
8379

STATE WELL NO. 16/LW-36P
COUNTY Lane
APPLICATION NO. GR-3317

OWNER: Andrea Winther Estate
Donald Malcolm Winther (Adm)


MAILING ADDRESS: 2295 River Loop #1

LOCATION OF WELL: Owner's No. Well #1

CITY AND STATE: Eugene, Oregon

SE 1/4 SW 1/4 Sec. 36 T. 16 N. S., R. 4 W., W.M.

Bearing and distance from section or subdivision corner 100' N. and 2350' E

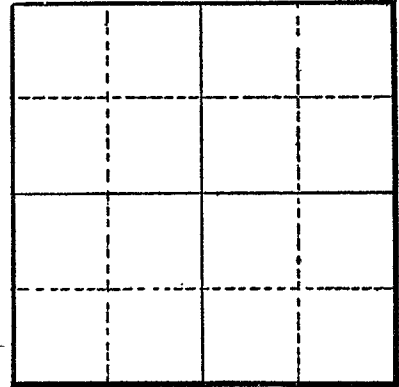

Section

Altitude at well

TYPE OF WELL: driven Date Constructed 1950

Depth drilled 21' Depth cased 21'

CASING RECORD:
4"

FINISH:

slotted from 18 to 21

AQUIFERS:

WATER LEVEL:

10'

PUMPING EQUIPMENT: Type Fairbanks Morse
Capacity 150 G.P.M.

H.P. 7 1/2

WELL TESTS:

Drawdown ft. after hours G.P.M.
Drawdown ft. after hours G.P.M.

USE OF WATER Irrigation Temp. °F., 19

SOURCE OF INFORMATION GR-3078

DRILLER or DIGGER

ADDITIONAL DATA:

Log Water Level Measurements Chemical Analysis Aquifer Test

REMARKS: