

STATE ENGINEER
Salem, Oregon

Well Record

STATE WELL NO. 16/4W-36P(1)
COUNTY Lane
APPLICATION NO. GR-985

LANE
8380

GR-954

OWNER: Orville G. Williamson

MAILING

ADDRESS: 2245 River Loop #1

LOCATION OF WELL: Owner's No. _____


CITY AND

STATE: Eugene, Oregon

SE 1/4 SW 1/4 Sec. 36 T. 16 S., R. 4 W., W.M.

Bearing and distance from section or subdivision

corner 1985' E. & 700' N. of the SW cor. of E 1/2
of Garret Maupin DLG.

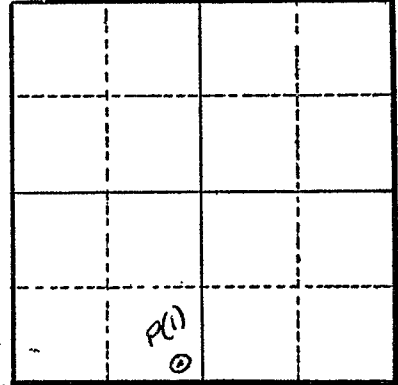

Section 36

Altitude at well 375 ft.

TYPE OF WELL: Driven Date Constructed 1943

Depth drilled 18 ft. Depth cased 18 ft.

CASING RECORD:

2- 2 in. driven 2 ft. apart.

FINISH:

Perforated with 1/4" slots (12 per ft.) from 16 to 18 ft.

AQUIFERS:

WATER LEVEL:

10 ft.

PUMPING EQUIPMENT: Type Fairbanks Morse 2" Centrifugal H.P. 10
Capacity 200 G.P.M.

WELL TESTS:

Drawdown _____ ft. after _____ hours _____ G.P.M.

Drawdown _____ ft. after _____ hours _____ G.P.M.

USE OF WATER Irrigation Temp. _____ °F., 19 _____

SOURCE OF INFORMATION G.R. Record

DRILLER or DIGGER _____

ADDITIONAL DATA:

Log _____ Water Level Measurements _____ Chemical Analysis _____ Aquifer Test _____

REMARKS:

Log: Sandy loam 0 to 10 ft.
Sand & gravel 10 to 18 ft.

Irrigation of 7 acres.