

STATE ENGINEER  
Salem, Oregon

# Well Record

STATE WELL NO. 16/4W-36Q  
COUNTY Lane  
APPLICATION NO. GR-2974

**LANE**  
**8381**

OWNER: Clifton H. Morgan


MAILING ADDRESS: 181 Rosetta Ave

LOCATION OF WELL: Owner's No. \_\_\_\_\_

CITY AND STATE: Eugene, Oregon

SW 1/4 SE 1/4 Sec. 36 T. 16 N. S., R. 4 E. W., W.M.

Bearing and distance from section or subdivision corner 400 feet North and 410 feet East from the S 1/4 Corner, Section 36.

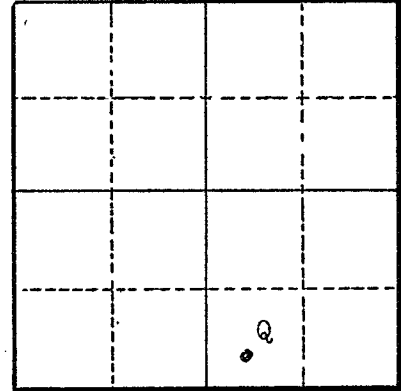

Section 36

Altitude at well \_\_\_\_\_

TYPE OF WELL: driven Date Constructed 1937

Depth drilled 23 feet Depth cased 23 feet

### CASING RECORD:

4-inch casing (cast iron) set from top to 23 feet

### FINISH:

### AQUIFERS:

river loam

### WATER LEVEL:

7 feet

PUMPING EQUIPMENT: Type Fairbanks Morris H.P. \_\_\_\_\_

Capacity 174 G.P.M.

### WELL TESTS:

Drawdown 2 ft. after \_\_\_\_\_ hours 200 G.P.M.

Drawdown \_\_\_\_\_ ft. after \_\_\_\_\_ hours \_\_\_\_\_ G.P.M.

USE OF WATER Irrigation Temp. \_\_\_\_\_ °F. \_\_\_\_\_, 19 \_\_\_\_\_

SOURCE OF INFORMATION GR-4061

DRILLER or DIGGER \_\_\_\_\_

### ADDITIONAL DATA:

Log X Water Level Measurements \_\_\_\_\_ Chemical Analysis \_\_\_\_\_ Aquifer Test \_\_\_\_\_

### REMARKS:

River loam 12 feet      11 feet gravel      19      23