

STATE ENGINEER
Salem, Oregon

LANE
8479

Well Record

STATE WELL NO. 16/5N-9
COUNTY Lane
APPLICATION NO. GR-2947

OWNER: E. S. Taylor Jr.


MAILING ADDRESS: Junction City, Oregon

LOCATION OF WELL: Owner's No.

CITY AND STATE:

SW 1/4 1/4 Sec. 9 T. 16 N. S., R. 5 E. W., W.M.

Bearing and distance from section or subdivision corner 2579' E. and 528' N.

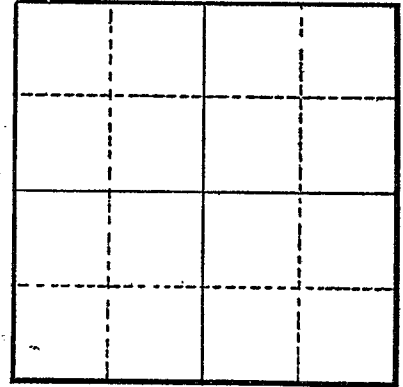

Section

Altitude at well

TYPE OF WELL: driven Date Constructed 1946
Depth drilled 25 Depth cased 25

CASING RECORD:

6-inch

FINISH:

4-6" x 3/16" from 21' to 25'

AQUIFERS:

WATER LEVEL: 13-feet

PUMPING EQUIPMENT: Type Denver Gardner Centrifugal H.P. 40
Capacity 500 G.P.M.

WELL TESTS:

Drawdown 8 ft. after hours Pumping 500 G.P.M.
Drawdown 6 ft. after hours Pumping 600 G.P.M.

USE OF WATER Irrigation Temp. °F., 19.

SOURCE OF INFORMATION GR-2768

DRILLER or DIGGER Owner

ADDITIONAL DATA:

Log Water Level Measurements Chemical Analysis Aquifer Test

REMARKS: