

STATE ENGINEER
Salem, Oregon

LANE
8531

Well Record

GR-932

STATE WELL NO. 16/5W-12E(1)
COUNTY Lane
APPLICATION NO. GR-961

OWNER: Ernold Hardisty

MAILING
ADDRESS:

LOCATION OF WELL: Owner's No.


CITY AND
STATE:

Junction, City, Oregon

SW $\frac{1}{4}$ NW $\frac{1}{4}$ Sec. 12 T. 16 S., R. 5 W., W.M.

Bearing and distance from section or subdivision

corner 300' N. & 600' E. from W $\frac{1}{4}$ cor. Sec. 12

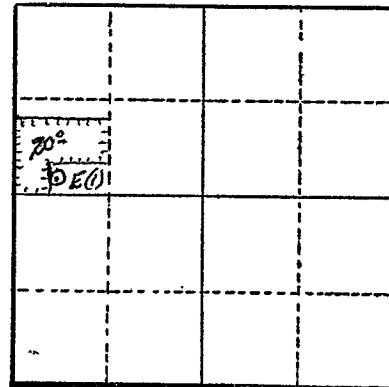

Altitude at well 323 ft.

TYPE OF WELL: Driven Date Constructed 1951

Depth drilled 21 ft. Depth cased

Section 12

CASING RECORD:

4 inch

FINISH:

AQUIFERS:

WATER LEVEL:

12 ft.

PUMPING EQUIPMENT: Type Pacific 1 $\frac{1}{2}$ " H.P. 5
Capacity 125 G.P.M.

WELL TESTS:

Drawdown 6 ft. after 125 hours G.P.M.

Drawdown ft. after hours G.P.M.

USE OF WATER Irrigation Temp. °F., 19

SOURCE OF INFORMATION G.R. Record

DRILLER or DIGGER Everett Scott

ADDITIONAL DATA:

Log Water Level Measurements Chemical Analysis Aquifer Test

REMARKS:

Irrigation of 20 acres.