

STATE ENGINEER
Salem, Oregon

LANE
8541

Well Record

STATE WELL NO. 16/5W-13G
COUNTY LANE
APPLICATION NO. GR-2761

OWNER: Ray E. Glass

MAILING ADDRESS: 1256 E. 21st. St.

LOCATION OF WELL: Owner's No.

CITY AND STATE: Eugene, Oregon

SW $\frac{1}{4}$ NE $\frac{1}{4}$ Sec. 13 T. 16 N. 5 E. S., R. W., W.M.

Bearing and distance from section or subdivision

corner 400' N. and 1700' W.

Altitude at well

TYPE OF WELL: driven Date Constructed 1932

Depth drilled 23 Depth cased 23

CASING RECORD:

2 $\frac{1}{2}$ -inch

FINISH:

Regular screen point.

AQUIFERS:

Regular soil

WATER LEVEL:

19-feet

PUMPING EQUIPMENT: Type Rotary H.P. 1
Capacity 300 G.P.M.

WELL TESTS:

Drawdown ft. after hours G.P.M.

Drawdown ft. after hours G.P.M.

USE OF WATER irrigation Temp. °F. 19

SOURCE OF INFORMATION GR-2612


DRILLER or DIGGER

ADDITIONAL DATA:

Log ☒ Water Level Measurements Chemical Analysis Aquifer Test

REMARKS:

Regular soil

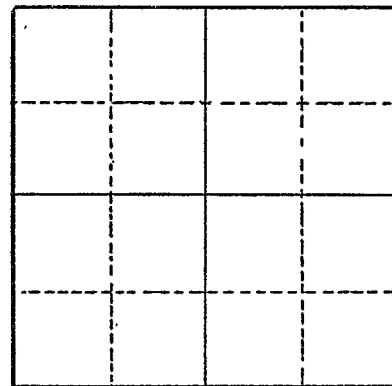

Section