

STATE ENGINEER
Salem, Oregon

LANE 8552
Well Record

STATE WELL NO. 16/5W-14J
COUNTY Lane
APPLICATION NO. GR-2093

OWNER: Glenn G. Nordyke

MAILING
ADDRESS: Route 1


LOCATION OF WELL: Owner's No.

CITY AND
STATE: Junction City, Oregon

NE 1/4 SE 1/4 Sec. 14 T. 16 N. S., R. 5 E. W., W.M.

Bearing and distance from section or subdivision

corner 790' W. & 1200' S.

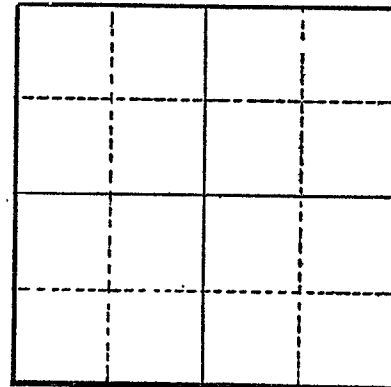

Section

Altitude at well

TYPE OF WELL: driven Date Constructed 1952

Depth drilled 41 Depth cased 28

CASING RECORD: 4 inch

FINISH: Perforations from 5 to 7 ft.

AQUIFERS:

WATER LEVEL: 15 ft.

PUMPING EQUIPMENT: Type Allis Chalmer single phase H.P. 5
Capacity 200 G.P.M.

WELL TESTS:

Drawdown 1 ft. after hours pumping 150 G.P.M.

Drawdown ft. after hours G.P.M.

USE OF WATER irrigation Temp. °F. 19

SOURCE OF INFORMATION GR-2010

DRILLER or DIGGER

ADDITIONAL DATA:

Log Water Level Measurements Chemical Analysis Aquifer Test

REMARKS:

LANE 8552
For Official Use Only:

Received Date: _____

County Well Log ID #

Well Identification Tag #

LANE 8552

24669

WELL IDENTIFICATION APPLICATION FORM **RECEIVED**

APR 21 1998

WATER RESOURCES DEPT.
SALEM, OREGON

BUYER/CURRENT WELL OWNER:

Name: Catherine C. Nordyke

Mailing Address: 92634 Alvarado Rd.

City: Junction City State: Ore. Zip: 97448 Phone: (541) 998-2747

WELL LOCATION:

County: Lane Owner's Well Number: Two (2)

Township: 16 N or S, Range: 05 E or W, Section: 14 0 1/4 0 1/4

Tax Lot Number: 00700 Type of Well: water supply ☒ monitoring ☐

Street Address of Well (if different from above): N/A

WELL INFORMATION: (do not complete remainder of application if well log is available)

Start Card Number: N/A Approx. Construction Date: 1954

Well Constructor: Unknown

Name of Owner at Time of Construction: Glenn & Catherine Nordyke

Well Depth (in feet): 31 feet Static Water Level (in feet): Unknown

Diameter of Exposed Well Casing (in inches): 3 inches

Does this well have a formal water right associated with it? Yes: ☐ No: ☒

If Yes: Application #: N/A Permit #: N/A Certificate #: N/A

Please Return Completed Form to:

Lisa Juul
Well Identification Program
Oregon Water Resources Department
158 12th Street NE
Salem, OR 97310