

STATE ENGINEER
Salem, Oregon.

LANE
8553

Well Record

STATE WELL NO. 16/5W-14Q(1)
COUNTY Lane
APPLICATION NO. GR-637

OWNER: Robert E. Crawford

MAILING
ADDRESS: Rt. 1

LOCATION OF WELL: Owner's No. 1

CITY AND
STATE: Junction City, Oregon

SW $\frac{1}{4}$ SE $\frac{1}{4}$ Sec. 14 T. 16 ~~N.~~ S., R. 5 ~~E.~~ W., W.M.

Bearing and distance from section or subdivision


corner S. $74^{\circ} 49'$ E. 2600.85 ft. to SE cor. Sec. 14

Altitude at well

TYPE OF WELL: driven Date Constructed 9/10/49

Depth drilled 20 Depth cased 20

CASING RECORD: 3 inch

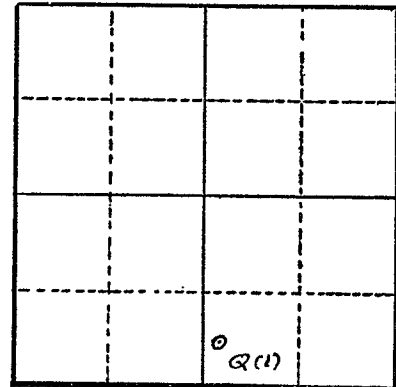

Section 14

FINISH:

AQUIFERS:

WATER LEVEL: 4 ft.

PUMPING EQUIPMENT: Type Rainflow centrifugal H.P. 5
Capacity 200 G.P.M.

WELL TESTS:

Drawdown ft. after hours G.P.M.

Drawdown ft. after hours G.P.M.

USE OF WATER irrigation 9.9 acres Temp. $^{\circ}$ F. 19

SOURCE OF INFORMATION GR-637

DRILLER or DIGGER Miller Jensen Co.; Eugene, Oregon

ADDITIONAL DATA:

Log ☒ Water Level Measurements Chemical Analysis Aquifer Test

REMARKS: Log: Blue clay 0 to 10 ft.
Gravel 10 to 20 ft.