

STATE ENGINEER
Salem, Oregon

LANE
8554

Well Record

STATE WELL NO. 16/5W-14(2)
COUNTY Lane
APPLICATION NO. GR-710

OWNER: Robert E. Crawford

MAILING
ADDRESS: Route 1

LOCATION OF WELL: Owner's No. 2

CITY AND
STATE: Junction City, Oregon

SW $\frac{1}{4}$ SE $\frac{1}{4}$ Sec. 14 T. 16 N. S. R. 5 E. W., W.M.

Bearing and distance from section or subdivision


corner S. $65^{\circ} 30'$ E. 2315 ft. to SE cor. Sec. 14

Altitude at well 335 estimated no map

TYPE OF WELL: driven Date Constructed 5/10/53

Depth drilled 20 ft. Depth cased 20 ft.

CASING RECORD: 4 inch

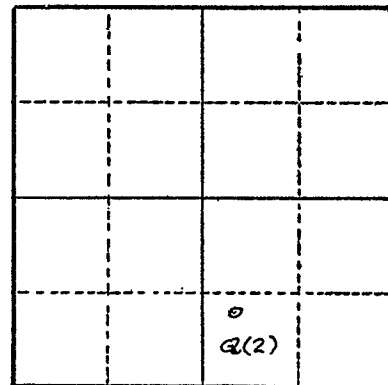

Section 14

FINISH:

AQUIFERS:

WATER LEVEL: 5 ft.

PUMPING EQUIPMENT: Type Rainflow centrifugal H.P. 5
Capacity 200 G.P.M.

WELL TESTS:

Drawdown ft. after hours G.P.M.

Drawdown ft. after hours G.P.M.

USE OF WATER irrigation 9.9 acres Temp. $^{\circ}$ F. 19

SOURCE OF INFORMATION GR-710

DRILLER or DIGGER Evertt Scott; Harrisburg, Oregon

ADDITIONAL DATA:

Log X Water Level Measurements Chemical Analysis Aquifer Test

REMARKS: Log: Blue clay 0 to 10 ft.
Gravel 10 to 20 ft.