

STATE ENGINEER
Salem, Oregon

Well Record

STATE WELL NO. 16/5W-21P
COUNTY Lane
APPLICATION NO. GR-3550

OWNER: Aaron Doak

MAILING

ADDRESS: Route 1

CITY AND

STATE: Junction City, Oregon

LOCATION OF WELL: Owner's No. _____

SE $\frac{1}{4}$ SW $\frac{1}{4}$ Sec. 21 T. 16 S., R. 5 W., W.M.

Bearing and distance from section or subdivision


corner 1700 ft. E. and 1150 ft. N. from SW

corner of Sec. corner

Altitude at well _____

TYPE OF WELL: Drilled Date Constructed 4/20/54

Depth drilled 149 ft. Depth cased 27 ft.

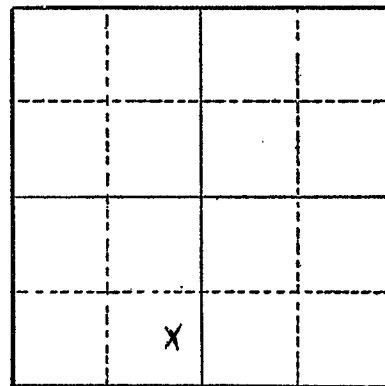

Section 21

CASING RECORD:

6 inch casing set to 27 feet

FINISH:

AQUIFERS:

sediments

WATER LEVEL:

58 feet below surface

PUMPING EQUIPMENT: Type Fairbanks Morris

H.P. 5

Capacity _____ G.P.M.

WELL TESTS:

Drawdown 12 ft. after _____ hours 2400 G.P.M.

Drawdown _____ ft. after _____ hours _____ G.P.M.

USE OF WATER Irrigation Temp. _____ °F., 19

SOURCE OF INFORMATION Well Registration Statement

DRILLER or DIGGER _____

ADDITIONAL DATA:

Log X Water Level Measurements _____ Chemical Analysis _____ Aquifer Test _____

REMARKS:

Log:

Silt loam

Clay loam

Red Shale

Blue hard rock

Stradified layers of rock and gravel

Thickness

Depth to Bottom

2

2

12

14

26

40

45

85

64

149