

STATE ENGINEER
Salem, Oregon

LANE
8708

Well Record

STATE WELL NO. 16/5W - 23P
COUNTY LANE
APPLICATION NO. GR-1978

OWNER: Kenneth R. Drew

MAILING

ADDRESS: Route 1, Box 40

LOCATION OF WELL: Owner's No. _____


CITY AND

STATE: Junction City, Oregon

SE $\frac{1}{4}$ SW $\frac{1}{4}$ Sec. 23 T. 16 S., R. 5 W., W.M.

Bearing and distance from section or subdivision

corner 24' N. & 336' W.

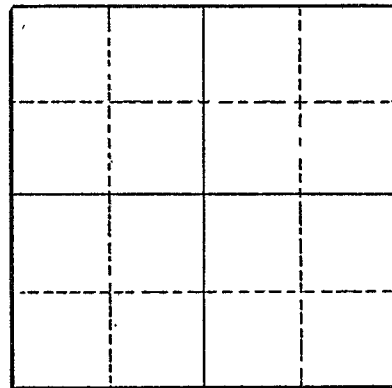

Altitude at well _____

TYPE OF WELL: Driven Date Constructed 1951

Depth drilled 12' Depth cased _____

Section _____

CASING RECORD:

FINISH:

Slots $\frac{3}{16}$ X 12" 8 per circle on $3\frac{1}{2}$ ' from Bottom
three circles pipe pointed on end.

AQUIFERS:

Gravel

WATER LEVEL:

18-feet

PUMPING EQUIPMENT: Type Fairbanks Morse
Capacity 250 G.P.M.

H.P. 7 $\frac{1}{2}$

WELL TESTS:

Drawdown 7 ft. after _____ hours Pumping 500 G.P.M.

Drawdown _____ ft. after _____ hours _____ G.P.M.

USE OF WATER Irrigation Temp. _____ °F., 19 _____

SOURCE OF INFORMATION GR-1909

DRILLER or DIGGER Miller Jensen Co.

ADDITIONAL DATA:

Log X Water Level Measurements _____ Chemical Analysis _____ Aquifer Test _____

REMARKS:

Pea gravel

9' to 33'