

STATE ENGINEER
Salem, Oregon

Well Record

STATE WELL NO. 16/6W-26R
COUNTY Lane
APPLICATION NO. GR-3095

OWNER: Edwin R. DeGraw

MAILING

ADDRESS: Star Route

LOCATION OF WELL: Owner's No.

CITY AND

STATE: Cheshire, Oregon

SE 1/4 SE 1/4 Sec. 26 T. 16 N. S. R. 6 E. W., W.M.


Bearing and distance from section or subdivision

corner S. 87° 02' W., 1667.0 feet

Altitude at well

TYPE OF WELL: Drilled Date Constructed 1947

Depth drilled 76 feet Depth cased 22 feet

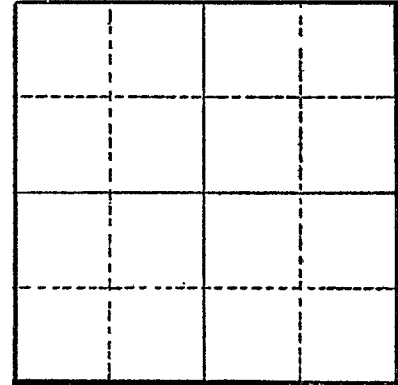

Section

CASING RECORD:

4-inch

FINISH:

General purpose type foot with seive type screen.

AQUIFERS:

Topsoil, clay, shale

WATER LEVEL:

10 feet

PUMPING EQUIPMENT: Type Deep Well Homart

H.P. 1

Capacity 24 G.P.M.

WELL TESTS:

Drawdown 0 ft. after hours Pumping 30 G.P.M.

Drawdown ft. after hours G.P.M.

USE OF WATER Irrigation

Temp. °F. 19

SOURCE OF INFORMATION GR-2903

DRILLER or DIGGER Halloway of Monroe

ADDITIONAL DATA:

Log X Water Level Measurements Chemical Analysis Aquifer Test

REMARKS:

Topsoil and clay

22'

Shale

54'

Hit water twice going through shale but not adequate amounts. Kept drilling until present level was reached when water gushed out and over top of casing about 3 minutes. Water settled back to present level of 10' below surface and has stayed there ever since.