

STATE ENGINEER
Salem, Oregon

LANE
9445

Well Record

STATE WELL NO. 16/2-31H
COUNTY Lane
APPLICATION NO. GR-3511

GR- 1230

OWNER: U. S. Corps of Engineers


MAILING ADDRESS: 628 Pittock Blk.

LOCATION OF WELL: Owner's No.

CITY AND STATE: Portland 5, Oregon

SE 1/4 NE 1/4 Sec. 31 T. 16 S., R. 2 E. XX, W.M.

Bearing and distance from section or subdivision
corner 887' S. 54° E. to cor. Sec. 31.

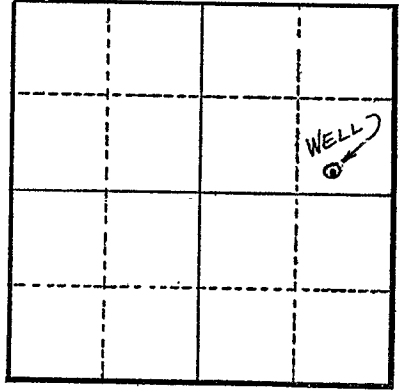

Section 31

Altitude at well 753 ft.

TYPE OF WELL: Drilled Date Constructed 1952

Depth drilled 75 ft. Depth cased 61.5 ft.

CASING RECORD:

8 inch from 0 to 61.5 ft.

FINISH:

Perforated: 6 rows of holes 1 inch apart from 37.5 to 61.5 ft.

AQUIFERS:

WATER LEVEL:

33 ft.

PUMPING EQUIPMENT: Type Pomona Deep well turbine H.P. 5
Capacity 100 G.P.M.

WELL TESTS:

Drawdown	12	ft. after	hours	70	G.P.M.
Drawdown	34	ft. after	hours	95	G.P.M.

USE OF WATER Industrial Temp. °F. 19

SOURCE OF INFORMATION G. R. Record

DRILLER or DIGGER Casey Jones

ADDITIONAL DATA:

Log Water Level Measurements Chemical Analysis Aquifer Test

REMARKS:

Log: Sand, gravel & boulders 0 to 17 ft.
 Sand & gravel 17 to 20 ft.
 Sand, gravel & boulders 20 to 32 ft.
 Sand & gravel 32 to 60 ft.
 Red lava rock 60 to 75 ft.