

STATE ENGINEER
Salem, Oregon

LANE Well Record

9921

GR-1623

STATE WELL NO. 17/1W-23L
COUNTY Lane
APPLICATION NO. GR-1672

OWNER: Everett Wearin


MAILING ADDRESS: Rt. 2, Box 13870

LOCATION OF WELL: Owner's No.

CITY AND STATE: Springfield, Oregon

NE $\frac{1}{4}$ SW $\frac{1}{4}$ Sec. 23 T. 17 S. R. 1 W., W.M.

Bearing and distance from section or subdivision
corner 2300' E. & 920' S. from W $\frac{1}{4}$ cor. Sec. 23.

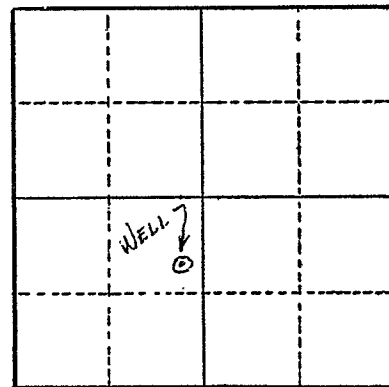

Altitude at well

TYPE OF WELL: Driven Date Constructed 1949

Depth drilled 20' Depth cased 20'

Section 23

CASING RECORD:

2 - 2"

FINISH:

AQUIFERS:

Sand, gravel & cement gravel at bottom

WATER LEVEL:

6'

PUMPING EQUIPMENT: Type Jacuzzi 1 $\frac{1}{2}$ " Cent. H.P. 2
Capacity 50 G.P.M.

WELL TESTS:

Drawdown 2 ft. after 50 hours G.P.M.
Drawdown ft. after hours G.P.M.

USE OF WATER Irrigation Temp. °F. 19

SOURCE OF INFORMATION GR Record

DRILLER or DIGGER Don't know

ADDITIONAL DATA:

Log N.A. Water Level Measurements Chemical Analysis Aquifer Test

REMARKS:

Irrigation of 1 acre.