

STATE ENGINEER
Salem, Oregon

LANE
9959

Well Record

STATE WELL NO. 17/1W-24A
COUNTY Lane
APPLICATION NO. GR-3436

OWNER: Lloyd Koozer


MAILING ADDRESS: 15495 McKenzie Hiway.

LOCATION OF WELL: Owner's No.

CITY AND STATE: Springfield, Oregon

NE 1/4 NE 1/4 Sec. 24 T. 17 N. S. R. 1 E. W., W.M.

Bearing and distance from section or subdivision corner 600' S.

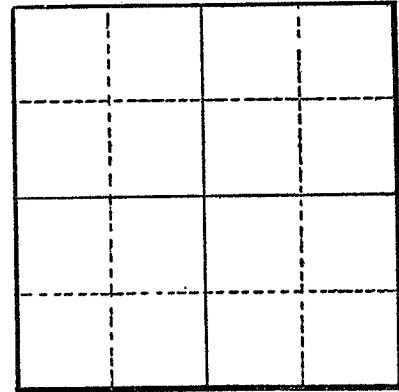

Section

Altitude at well

TYPE OF WELL: driven Date Constructed 1955

Depth drilled 20' Depth cased

CASING RECORD:

FINISH:

AQUIFERS:

WATER LEVEL:

14'

PUMPING EQUIPMENT: Type H.P.
Capacity G.P.M.

WELL TESTS:

Drawdown ft. after hours pumping 300 G.P.M.
Drawdown 4 ft. after hours pumping 100 G.P.M.

USE OF WATER Irrigation Temp. °F., 19

SOURCE OF INFORMATION GR-3177

DRILLER or DIGGER

ADDITIONAL DATA:

Log Water Level Measurements Chemical Analysis Aquifer Test

REMARKS: