

STATE ENGINEER
Salem, Oregon

LANE Well Record
9960

STATE WELL NO. 17/LW-24A
COUNTY Lane
APPLICATION NO. GR-2939

OWNER: Charles P. DeMoss

MAILING

ADDRESS: 15325 McKenzie Highway


LOCATION OF WELL: Owner's No.

CITY AND

STATE: Waltherville, Oregon

NE 1/4 NE 1/4 Sec. 24 T. 17 N. S. R. 1 E. W.M.

Bearing and distance from section or subdivision
corner 1228' N. 45' W

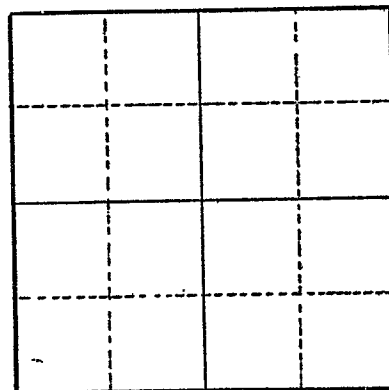

Section

Altitude at well

TYPE OF WELL: driven Date Constructed 1953

Depth drilled 20 Depth cased

CASING RECORD:

FINISH:

AQUIFERS:

Topsoil, sand and gravel

WATER LEVEL: 14-feet

PUMPING EQUIPMENT: Type Montgomery Ward Centrifugal H.P. 3
Capacity 100 G.P.M.

WELL TESTS:
Drawdown 4 ft. after hours Pumping 100 G.P.M.
Drawdown ft. after hours G.P.M.

USE OF WATER Irrigation Temp. °F. 19

SOURCE OF INFORMATION GR-2764

DRILLER or DIGGER

ADDITIONAL DATA:

Log X Water Level Measurements Chemical Analysis Aquifer Test

REMARKS:

Topsoil
Sand & gravel

2
18