

## GEOTECHNICAL HOLE REPORT

LINC 50367

Received date

(as required by OAR 690-240-035)

**(1) OWNER/PROJECT**Name **KEN WELLS**Street **20 SE SCHOOLHOUSE ST**City **DEPOE BAY** State **OR** Zip **97341**Hole No. **1**  
Co. Job No. **305****(2) TYPE OF WORK**

- ☒ New ☐ Alter (Recondition) ☐ Alter (Repair)  
☐ Deepening ☐ Abandonment

**(3) CONSTRUCTION**

- ☐ Rotary Air ☐ Hand Auger ☐ Hollow Stem Auger  
☐ Rotary Mud ☐ Cable Tool ☒ Push Probe Other

**(4) TYPE OF HOLE**

- ☒ Uncased Temporary ☐ Cased Permanent  
☐ Uncased Permanent ☐ Slope Stablilt Other

**(5) USE OF HOLE****(6) BORE HOLE CONSTRUCTION**Special Standards ☐ Depth of completed well **14** ft.

HOLE

| Diameter | From | To |
|----------|------|----|
| 1.50     | 0    | 14 |

SEAL

| From | To | Material | Amount | Seal<br>Grout Weight | Units |
|------|----|----------|--------|----------------------|-------|
| 0    | 14 | BE       | 11     |                      | P     |

Backfill placed from \_\_\_\_\_ ft. TO \_\_\_\_\_ ft. Material \_\_\_\_\_  
 Filter pack placed from \_\_\_\_\_ ft. TO \_\_\_\_\_ ft. Size \_\_\_\_\_ in.

**(7) CASING/SCREEN**Screen ☐**(8) WELL TEST**

Permeability \_\_\_\_\_ Yield \_\_\_\_\_ GPM

Conductivity \_\_\_\_\_ PH \_\_\_\_\_

Temperature of water \_\_\_\_\_ °F/C Depth artesian flow found \_\_\_\_\_ ft.

Was water analysis done? ☒By Whom? **SML ASSOCIATES**

Depth of strata to be analyzed. From \_\_\_\_\_ ft. to \_\_\_\_\_ ft.

Remarks \_\_\_\_\_

Name of supervising Geologist/Engineer \_\_\_\_\_

**(9) LOCATION OF HOLE By legal description**

County **Lincoln** Latitude \_\_\_\_\_ Longitude \_\_\_\_\_  
 Township **9.00 S** Range **11.00 W**  
 Section **8** **SE 1/4 NW 1/4**  
 Tax lot \_\_\_\_\_ Lot \_\_\_\_\_ Block \_\_\_\_\_ Subdivision \_\_\_\_\_

Legal desc: \_\_\_\_\_

Street Address of Well (or nearest address)

**SAME AS ABOVE****MAP with location indentified must be attached****(10) STATIC WATER LEVEL**

Ft. below land surface. \_\_\_\_\_ Date \_\_\_\_\_

Artesian Pressure \_\_\_\_\_ lb/sq. in. \_\_\_\_\_ Date \_\_\_\_\_

**(11) SUBSURFACE LOG**

Ground Elevation \_\_\_\_\_ ft.

| Material     | From | To | SWL |
|--------------|------|----|-----|
| <b>SANDS</b> | 0    | 14 |     |

Date started **5/19/1997** Completed **5/19/1997****(12) ABANDONMENT LOG**

Date started \_\_\_\_\_ Completed \_\_\_\_\_

**Professional Certification**

(to be signed by a licensed water supply or monitoring well constructor, or registered geologist or civil engineer).

I accept responsibility for the construction, alteration, or abandonment work performed on this well during the construction dates reported above. All work performed during this time is in compliance with Oregon geotechnical hole construction standards. This report is true to the best of my knowledge and belief.

License or Registration Number **10402**Signed By **KEITH VIDOS**

Date \_\_\_\_\_

Affiliation **GEO-TECH EXPLORATIONS**


← N

(not to scale)

## SITE MAP

Depoe  
Bay  
Citor Hill

Schoolhouse Rd.

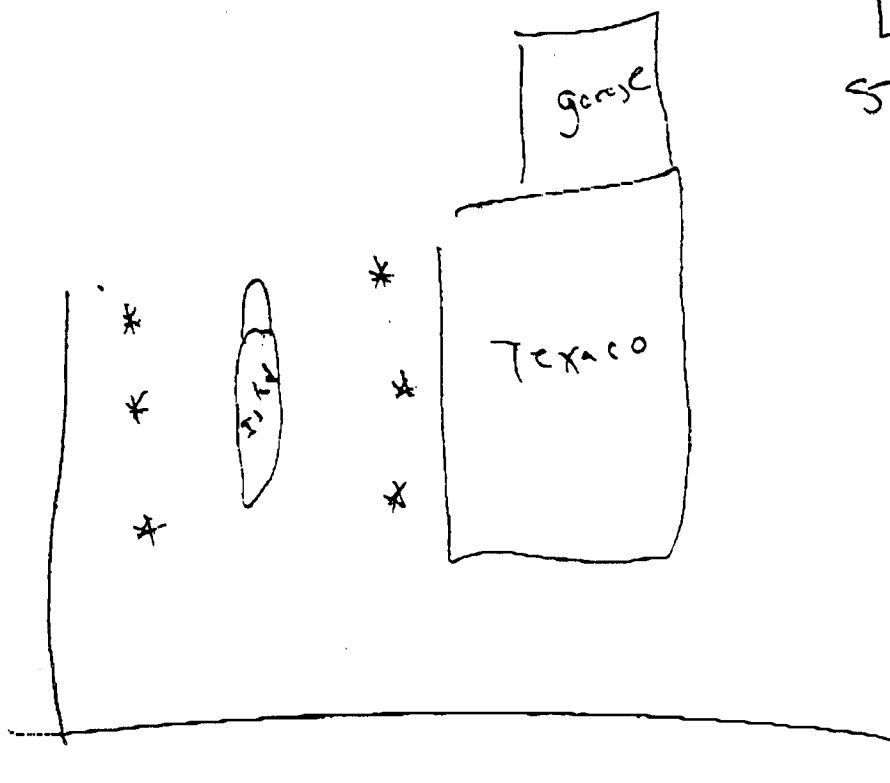

Lincoln  
50367 -  
50372

Hwy 101