

GEOTECHNICAL HOLE REPORT

LINC 50369

Received date

(as required by OAR 690-240-035)

(1) OWNER/PROJECTName **KEN WELLS**Street **20 SE SCHOOLHOUSE ST**City **DEPOE BAY** State **OR** Zip **97341**Hole No. **3**
Co. Job No. **305****(2) TYPE OF WORK**

- ☒ New ☐ Alter (Recondition) ☐ Alter (Repair)
☐ Deepening ☐ Abandonment

(3) CONSTRUCTION

- ☐ Rotary Air ☐ Hand Auger ☐ Hollow Stem Auger
☐ Rotary Mud ☐ Cable Tool ☒ Push Probe Other

(4) TYPE OF HOLE

- ☒ Uncased Temporary ☐ Cased Permanent
☐ Uncased Permanent ☐ Slope Stability Other

(5) USE OF HOLE**(6) BORE HOLE CONSTRUCTION**Special Standards ☐ Depth of completed well **14** ft.

HOLE

Diameter	From	To
1.50	0	14

SEAL

From	To	Material	Amount	Seal Grout Weight	Units
0	14	BE	11		P

Backfill placed from ft. TO ft. Material

Filter pack placed from ft. TO ft. Size in.

(7) CASING/SCREENScreen ☐**(8) WELL TEST**

Permeability Yield GPM

Conductivity PH

Temperature of water °F/C Depth artesian flow found ft.

Was water analysis done? ☒By Whom? **SML ASSOCIATES**

Depth of strata to be analyzed. From ft. to ft.

Remarks

Name of supervising Geologist/Engineer

(9) LOCATION OF HOLE By legal description

County **Lincoln** Latitude Longitude
 Township **9.00 S** Range **11.00 W**
 Section **8** **SE 1/4 NW 1/4**
 Tax lot Lot Block Subdivision

Legal desc:

Street Address of Well (or nearest address)

SAME AS ABOVE**MAP with location identified must be attached****(10) STATIC WATER LEVEL**

Ft. below land surface. Date

Artesian Pressure lb/sq. in. Date

(11) SUBSURFACE LOG

Ground Elevation ft.

Material	From	To	SWL
SANDS	0	14	

Date started **5/19/1997** Completed **5/19/1997****(12) ABANDONMENT LOG**

Date started Completed

Professional Certification

(to be signed by a licensed water supply or monitoring well constructor, or registered geologist or civil engineer).

I accept responsibility for the construction, alteration, or abandonment work performed on this well during the construction dates reported above. All work performed during this time is in compliance with Oregon geotechnical hole construction standards. This report is true to the best of my knowledge and belief.

License or Registration Number **10402**Signed By **KEITH VIDOS**

Date

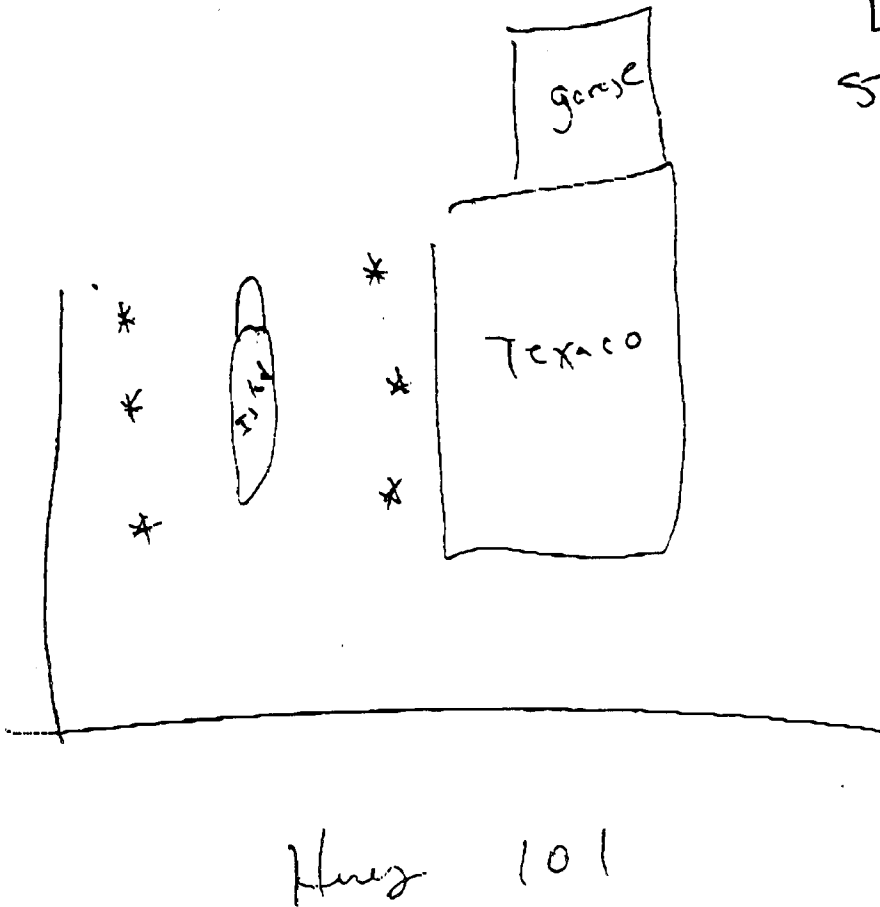
Affiliation **GEO-TECH EXPLORATIONS****THIS REPORT MUST BE SUBMITTED TO THE WATER RESOURCES DEPARTMENT WITHIN 30 DAYS OF COMPLETION OF WORK**

← N

(not to scale)

SITE MAPDepoe
Bay
City Hall

Schoolhouse Rd.

Lincoln
50367 -
50372