Received date

GEOTECHNICAL HOLE REPORT

LINC 50370


(as required by OAR 690-240-035)

(1) OWNER/PROJECT Hole No. 4			(9) LOCATION OF HOLE By legal description						
		Co.Job No. 30	5	County	Lincoln		Latitude		Longitude
Name KEN WELLS				Township	9.00	S	Range	11.00	w
Ct 00 05 0011001110	UOE OT			Section	8	S	E1/4 N	W 1/4	
Street 20 SE SCHOOLHO City DEPOE BAY		7in 97244		Tax lot	l	Lot	Block	\$	ubdivision
	State UK	Zip 97341		Legal desc:					
(2) TYPE OF WORK				Street Address of	Well (or near	est add	lress)		
New Alter (Recondition) Alter (Repair)				SAME AS ABOVE					
Deepening Abandonment				MAP with location indentified must be attached					
(3) CONSTRUCTION				(10) STATIC WATER LEVEL					
Rotary Air Hand Auger Hollow Stem Auger				Ft. below land surface. Date					
Rotary Mud Cable Tool Push Probe Other				Artesian Pressure Ib/sq. In. Date					
(4) TYPE OF HOLE	(11) SUBSU	RFACE I	LOG						
Uncased Temporary									
Uncased Permanent Slope Stabilit Other				Ground Eleva	tion	ft.			
(5) USE OF HOLE				Material From To SWL					
				SANDS		0	16		
				1					
(6) BORE HOLE CON	NSTRUCTION			1					
Special Standards	Depth of completed w	/ell							
Diameter F	rom To								
HOLE Diameter F	0 14								
From To	Material Am	ount Seal	Units						
SEAL		Grout Wei							
0 1	4 BE	11	Р						
Backfill placed from	ft. TO	ft. Material							
Filter pack placed from	ft. TO	ft. Size	in.	Date started	5/	/19/19	997 Com	pleted	5/19/1997
(7) CASING/SCREEN			····	(12) 49 400	ONIMENIA	FIO			***
TO CHISTING OF CHEED !	•			(12) ABAND	<u>UINIMEIN I</u>	LOC	<u> </u>		
Screen									
							-		
				Date started			Com	pleted	
(8) WELL TEST				Professional	Certificati	on		***	
Permeability	Yield GP!	M		(to be signed by a li geologist or civil en	icensed wate	r supply	y or monitori	ng well cons	tructor, or registered
Conductivity	PH					onstruct	tion alteratio	n orahand	onment work performed
Temperature of water	°F/C Depth artesi	an flow found	ft.	on this well during t	ne constructi	on date	es reported a	bove. All wo	rk performed during this
Was water analysis done?	\boxtimes			time is in compliant report is true to the	e with Orego best of my kr	n geote	echnical hole	constructio	n standards. This
By Whom? SML ASSOCIAT	ES								
Depth of strata to be analyzed.	. From	ft. to	ft.			Lice	ense or Regi	istration Nur	nber 10402
Remarks				Signed By KEI 1	TH VIDOS				Date
Name of supervising Geologist	Affiliation GEO-TECH EXPLORATIONS								

 $\leftarrow N$

(not to scale)

SITE MAP

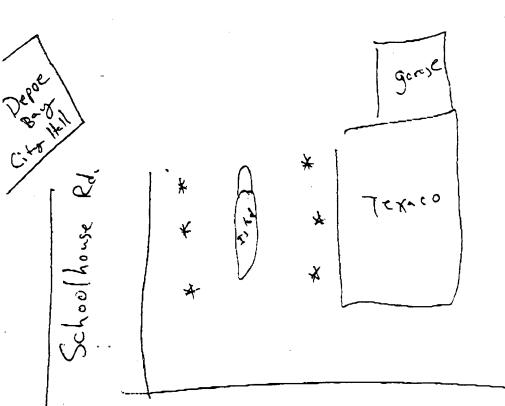

Lincoln 50367-50372

Huez 101