Received date


LINC 50372


(as required by OAR 690-240-035)

(I) OWNER/PROJECT	(9) LOCATION OF HOLE By legal description								
	Co.Job No. 305		County	Lincoln		Latitude	L	- ongitude	
KEN WELLS Name			Township	9.00	S	Range	11.00 V	•	
Turne			Section	8	SI	E 1/4 N	W 1/4		
Street 20 SE SCHOOLHOUSE ST	D 7' 000//		Tax lot		Lot	Block	Sub	division	
	R Zip 97341		Legal desc:						
(2) TYPE OF WORK			Street Address of W	Vell (or near	est addr	ress)			
New Alter (Recondit		SAME AS ABOVE							
Deepening Abandonment			MAP	with loca	tion ir	ndentifie	d must be	attached	
(3) CONSTRUCTION			(10) STATIC WATER LEVEL						
Rotary Air Hand Auger Hollo	ow Stem Auger		Ft. below land surface. Date						
Rotary Mud Cable Tool Push	Probe Other		Artesian Pressure Ib/sq. in. Date						
(4) TYPE OF HOLE			(11) SUBSURFACE LOG						
Uncased Temporary Cased Permane	ent								
Uncased Permanent Slope Stabilit	Other		Ground Elevation ft.						
(5) USE OF HOLE			Material	ı F	rom	То	SWL		
			SILTS		0	14			
(6) BORE HOLE CONSTRUCTION									
Special Standards Depth of completed	14 ft.								
HOLE Diameter From To 1.50 0 14									
	mount Seal	⊺Units]							
SEAL	Grout Weight								
0 14 BE	11	Р							
Backfill placed from ft. TO	ft. Material	_ 1	Date started	5.	/19/19	997 Com	pleted	5/19/1997	
Filter pack placed from ft. TO	ft. Size i	n.							
(7) CASING/SCREEN			(12) ABANDO	<u>ONMEN'I</u>	<u>T LOG</u>	<u> </u>			
Screen 🖳									
		†	Date started			Com	pleted		
(8) WELL TEST			Professional C	Certificati	ion				
	SPM .		(to be signed by a lice	censed water		or monitori	ng well constr	uctor, or registered	
Conductivity PH			geologist or civil eng	gineer).			•		
Temperature of water °F/C Depth arte	I accept responsibility for the construction, alteration, or abandonment work performed on this well during the construction dates reported above. All work performed during this								
Was water analysis done?	time is in compliance with Oregon geotechnical hole construction standards. This report is true to the best of my knowledge and belief.								
By Whom? SML ASSOCIATES			report is true to the b	pest of my k	nowledg	ge and belief	г.		
Depth of strata to be analyzed. From	ft. to	ft.			Lice	ense or Rea	istration Numb	per 10402	
Remarks			Cignod D. 145	111//2000					
Romains			Signed By KEIT	H VIDOS				Date	
Name of supervising Geologist/Engineer			Affiliation GEO-T	TECH EXPL	ORATIO	ONS			

 $\leftarrow N$

(not to scale)

SITE MAP

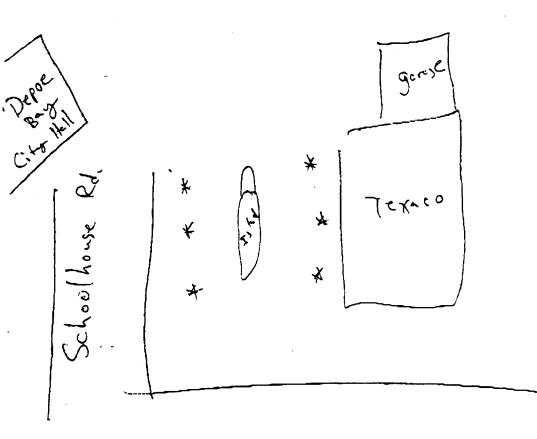

Lincoln 50367-

Hus 101