



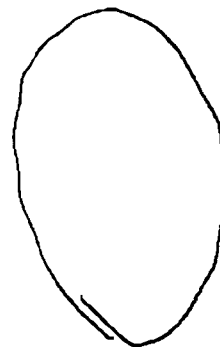

Lincoln  
50629-  
50632

HWY 101

SOUTHPOINT DEPOT  
BAY

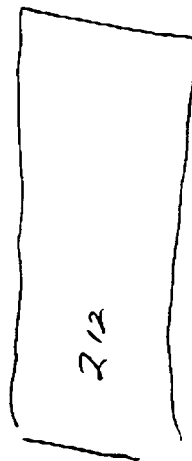

P-1  
P-1  
P-2

