

STATE ENGINEER
Salem, Oregon

LINN Well Record

10024

GR- 1411

STATE WELL NO. 12/2W-29M
COUNTY Linn
APPLICATION NO. GR- 1462

OWNER: R. G. & Ruth Stearns

MAILING

ADDRESS: Rt. 2, Box 82

LOCATION OF WELL: Owner's No.


CITY AND

STATE: Lebanon, Oregon

NW 1/4 SW 1/4 Sec. 29 T. 12 N. S., R. 2 W., W.M.

Bearing and distance from section or subdivision

corner N. 54° 50' E. 32.5 ch. from most Wly NW cor.
of DLO #73.

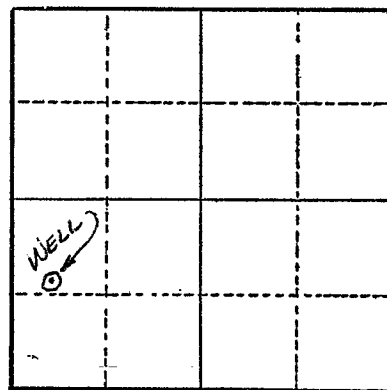

Altitude at well 400'

TYPE OF WELL: Drilled Date Constructed 1951

Depth drilled 120' Depth cased 18'

Section 29

CASING RECORD:

6"

FINISH:

AQUIFERS:

WATER LEVEL:

60'

PUMPING EQUIPMENT: Type Myers 2 1/2" jet H.P. 3
Capacity 30 G.P.M.

WELL TESTS:

Drawdown 10 ft. after 40 hours G.P.M.

Drawdown ft. after hours G.P.M.

USE OF WATER Irrigation Temp. °F. 19

SOURCE OF INFORMATION GR Record

DRILLER or DIGGER Shafer & Gallatly

ADDITIONAL DATA:

Log Water Level Measurements Chemical Analysis Aquifer Test

REMARKS:

Log: Surface clay & sand 0 to 17 ft.
Shale & Streaks of blue clay 17 to 88 ft.
Shale & sandstone (water) 88 to 120 ft.

Irrigation of 4.5 acres.