

STATE ENGINEER
Salem, Oregon

LINN
10036

Well Record

STATE WELL NO. 12/2W-31Q
COUNTY Linn
APPLICATION NO. GR-3205


OWNER: Gilbert S. and Norma N. Morgan
MAILING ADDRESS: Route 2

LOCATION OF WELL: Owner's No. _____
CITY AND STATE: Lebanon, Oregon

SW $\frac{1}{4}$ SE $\frac{1}{4}$ Sec. 31 T. 12 N S. R. 2 E W., W.M.

Bearing and distance from section or subdivision

corner S. 27° W. 32 chs. from NE Corner of
D.L.C. 57

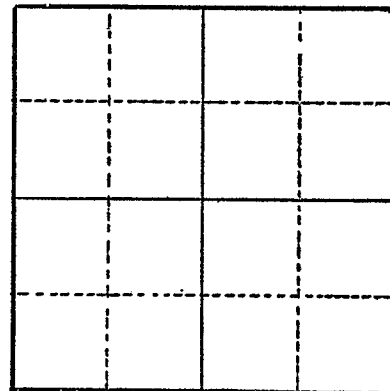

Section _____

Altitude at well _____

TYPE OF WELL: drilled Date Constructed 1955

Depth drilled 74 Depth cased 74

CASING RECORD:

8" steel casing from 0 to 74 feet

FINISH:

slot perforations from 25 to 30 feet

slot perforations from 65 to 74 feet

AQUIFERS:

WATER LEVEL:

28'

PUMPING EQUIPMENT: Type Delco Deep Well H.P. 3
Capacity 200 G.P.M.

WELL TESTS:
Drawdown 50 ft. after _____ hours pumping 800 G.P.M.
Drawdown _____ ft. after _____ hours _____ G.P.M.

USE OF WATER irrigation Temp. _____ °F. _____, 19

SOURCE OF INFORMATION GR-2982

DRILLER or DIGGER Herald Baird Hiatt St. Lebanon, Oregon

ADDITIONAL DATA:

Log _____ Water Level Measurements _____ Chemical Analysis _____ Aquifer Test _____

REMARKS: