

STATE ENGINEER
Salem, Oregon

LINN
10395

Well Record


STATE WELL NO. 12/3W-3A
COUNTY Linn
APPLICATION NO. Gr-3211

OWNER: R. H. Murphy MAILING ADDRESS: Route 1, Box

LOCATION OF WELL: Owner's No. _____ CITY AND STATE: Albany, Oregon

NE $\frac{1}{4}$ NE $\frac{1}{4}$ Sec. 3 T. 12 N. S., R. 3 4. W., W.M.

Bearing and distance from section or subdivision corner 660' S. and 132' W. of N.E. corner of Section 3

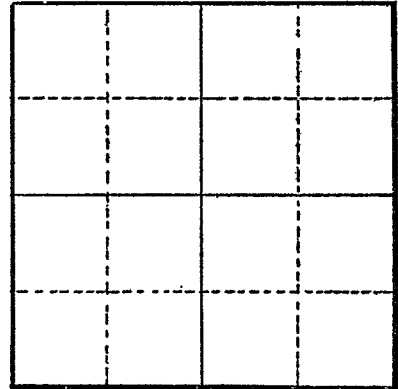

Section

Altitude at well _____

TYPE OF WELL: drilled Date Constructed 1947

Depth drilled 69 Depth cased 69

CASING RECORD:

10 inch

FINISH:

Slot perforations from 8 to 69

AQUIFERS:

WATER LEVEL:

4 feet

PUMPING EQUIPMENT: Type Cook Turbine H.P. 7 $\frac{1}{2}$
Capacity 150 G.P.M.

WELL TESTS:

Drawdown _____ ft. after _____ hours _____ G.P.M.
Drawdown _____ ft. after _____ hours _____ G.P.M.

USE OF WATER Irrigation Temp. _____ °F. _____, 19____

SOURCE OF INFORMATION CR-2988

DRILLER or DIGGER William A. Sloper Independence, Oregon

ADDITIONAL DATA:

Log _____ Water Level Measurements _____ Chemical Analysis _____ Aquifer Test _____

REMARKS: