

STATE ENGINEER
Salem, Oregon

LINN
10419

Well Record

STATE WELL NO. 12/3W-5B
COUNTY LINN
APPLICATION NO. GR-2446

OWNER: Willard and Dorothy Stapler


MAILING ADDRESS: Rt. 3, Box 1082,

LOCATION OF WELL: Owner's No.

CITY AND STATE: Albany, Oregon

NW 1/4 NE 1/4 Sec. 5 T. 12 S. R. 3 W., W.M.

Bearing and distance from section or subdivision
corner 1254' S. and 1914' W.

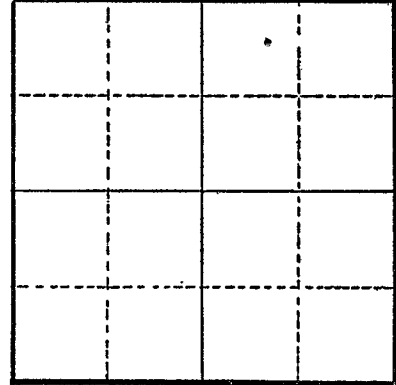

Section

Altitude at well

TYPE OF WELL: Drilled Date Constructed 1951

Depth drilled 95 Depth cased 90'-9"

CASING RECORD:

8-inch

FINISH:

Slot perforations from 67 to 90

AQUIFERS:

Clay, boulders, sand and gravel

WATER LEVEL:

20-feet

PUMPING EQUIPMENT: Type Deep well turbine H.P. 5

Capacity 150 G.P.M.

WELL TESTS:

Drawdown ft. after hours G.P.M.

Drawdown ft. after hours G.P.M.

USE OF WATER Irrigation Temp. °F., 19

SOURCE OF INFORMATION GR-2318

DRILLER or DIGGER

ADDITIONAL DATA:

Log Water Level Measurements Chemical Analysis Aquifer Test

REMARKS:	Clay	12	12
	Clay and Boulders	16	28
	Clay and Gravel	17	45
	Sand and Clay	7	52
	Gravel and Clay	12	64
	Sand, Gravel and Clay	22	86
	Sand and Gravel	9	95