

STATE ENGINEER  
Salem, Oregon

LINN  
10421

OBSERVATION WELL  
Well Record


STATE WELL NO. 12/3W-5K(1)  
COUNTY Linn  
APPLICATION NO. GR-322

OWNER: George N. & Hazel C. Chandler  
MAILING ADDRESS: Rt. 3, Box 1086

LOCATION OF WELL: Owner's No. 1  
CITY AND STATE: Albany, Oregon

NW 1/4 SE 1/4 Sec. 5 T. 12 N. S. R. 3 W., W.M.

Bearing and distance from section or subdivision  
corner S. 32° 18' E. 8.28 chs. from NW cor. SE 1/4  
Sec. 5

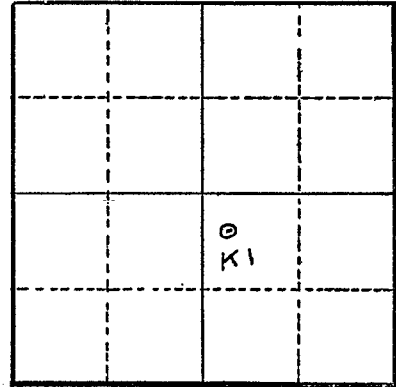

Section 5

Altitude at well 252 ft. Interpolated

TYPE OF WELL: drilled Date Constructed 11/7/52

Depth drilled 111 ft. Depth cased 111 ft.

CASING RECORD: 8 in. plain end welded pipe set from 0 to 111 ft.

FINISH: Slit perforations set from 58 to 80 ft.  
(mills knife) from 89 to 108 ft.  
from 92 to 111 ft.

AQUIFERS: Sand & gravel ( 40 to 58 ft.  
( 61 to 78 ft.  
( 102 to 111 ft.

WATER LEVEL: 20 ft. below land surface

PUMPING EQUIPMENT: Type Fairbanks Morse turbine H.P. 10  
Capacity 400 G.P.M.

WELL TESTS:  
Drawdown 45 ft. after ..... hours pumping 150 G.P.M.  
Drawdown 68 ft. after ..... hours pumping 250 G.P.M.

USE OF WATER irrigation 42 acres Temp. °F. ...., 19

SOURCE OF INFORMATION Reg. St. GR-322

DRILLER or DIGGER

ADDITIONAL DATA:  
Log X Water Level Measurements ..... Chemical Analysis ..... Aquifer Test .....

REMARKS:

