

STATE ENGINEER
Salem, Oregon

LINN 10477
Well Record

STATE WELL NO. 12/LW - 1J
COUNTY LINN
APPLICATION NO. GR-2210

OWNER: O. A. and Lola M. Cade


MAILING
ADDRESS: Tangent,

LOCATION OF WELL: Owner's No.

CITY AND
STATE: Oregon

NE $\frac{1}{4}$ SE $\frac{1}{4}$ Sec. 1 T. 12 N. 4 E. W., W.M.

Bearing and distance from section or subdivision
corner N. 35° 30' W. 27 chains

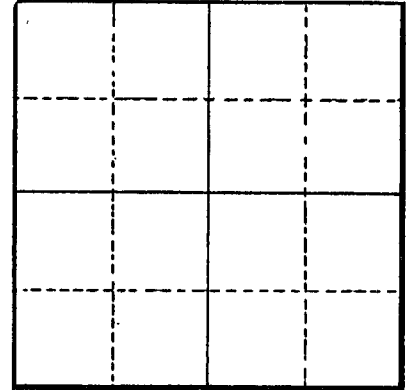

Altitude at well

TYPE OF WELL: Drilled Date Constructed 1951

Depth drilled 65 Depth cased 65

Section

CASING RECORD:

6-Inch

FINISH:

Perforations from 20 to 25
Perforations from 55 to 65

AQUIFERS:

WATER LEVEL:

22-Feet

PUMPING EQUIPMENT: Type Pacific Centrifugal H.P. 5
Capacity 200 G.P.M.

WELL TESTS:

Drawdown 55 ft. after hours Pumping 250 G.P.M.
Drawdown ft. after hours G.P.M.

USE OF WATER Irrigation Temp. °F., 19

SOURCE OF INFORMATION GR-2115

DRILLER or DIGGER Slate Drilling Co., Tangent, Oregon

ADDITIONAL DATA:

Log Water Level Measurements Chemical Analysis Aquifer Test

REMARKS: