


LINN  
10495

OWNER: Orville O. or Bonnie G. Doerfler MAILING ADDRESS: Rt. 3, Box 863  
LOCATION OF WELL: Owner's No. 1 CITY AND STATE: Albany, Oregon

NE 1/4 SE 1/4 Sec. 4 T. 12 S., R. 4 W., W.M.

Bearing and distance from section or subdivision  
corner N. 35° 50' W. 23.5 chs. from SE cor. Sec. 4

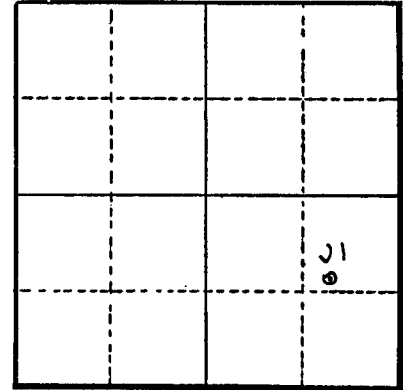

Section 4

Altitude at well

TYPE OF WELL: drilled Date Constructed 1947

Depth drilled 59 ft. Depth cased

CASING RECORD: 6 in. steel 0 to 59 ft.

FINISH: Slot perforations 49 to 59 ft.

AQUIFERS:

WATER LEVEL: 7 ft.

PUMPING EQUIPMENT: Type deep well turbine H.P. 1 1/2 elec.  
Capacity 60 G.P.M.

WELL TESTS:  
Drawdown 15 ft. after hours 100 G.P.M.  
Drawdown ft. after hours G.P.M.

USE OF WATER irrigation Temp. °F. , 19

SOURCE OF INFORMATION owner

DRILLER or DIGGER

ADDITIONAL DATA:  
Log Water Level Measurements Chemical Analysis Aquifer Test

REMARKS: