

STATE ENGINEER
Salem, Oregon

LINN
10496

LINN 10496

STATE WELL NO. 12/48-4L
COUNTY LINN
APPLICATION NO. GR-2773

OWNER: Gilbert and Ruth Beach


MAILING ADDRESS: P. O. Box 647,

LOCATION OF WELL: Owner's No.

CITY AND STATE: Corvallis, Oregon

NE 1/4 SW 1/4 Sec. 4 T. 12 N. S., R. 4 E. W., W.M.

Bearing and distance from section or subdivision corner 1600' N. and 1325' E.

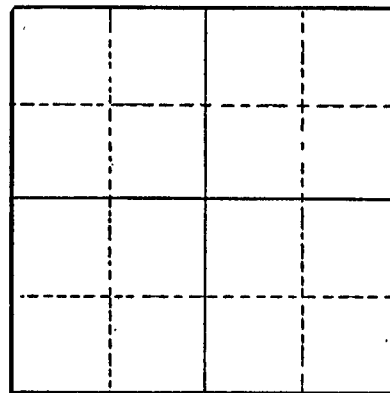

Section

Altitude at well

TYPE OF WELL: drilled Date Constructed 1943

Depth drilled 45 Depth cased

CASING RECORD:

12-inch

FINISH:

AQUIFERS:

WATER LEVEL:
10-feet

PUMPING EQUIPMENT: Type Fairbanks Morse Centrifugal H.P. 5
Capacity 225 G.P.M.

WELL TESTS:

Drawdown ft. after hours G.P.M.
Drawdown ft. after hours G.P.M.

USE OF WATER irrigation Temp. °F. 19

SOURCE OF INFORMATION GR-2622

DRILLER or DIGGER

ADDITIONAL DATA:

Log Water Level Measurements Chemical Analysis Aquifer Test

REMARKS: