

STATE ENGINEER
Salem, Oregon

LINN 10520
LINN 10520 Well Record

STATE WELL NO. 12/4N-5C
COUNTY Linn
APPLICATION NO. GR-3807

OWNER: Richard C. Eisenbrandt


MAILING ADDRESS: Route 4, Box 334

LOCATION OF WELL: Owner's No.

CITY AND STATE: Corvallis, Oregon

NE 1/4 NW 1/4 Sec. 5 T. 12 S. R. 4 W., W.M.

Bearing and distance from section or subdivision corner 1122' S. & 1485' E. of NW Cor. Sec. 5

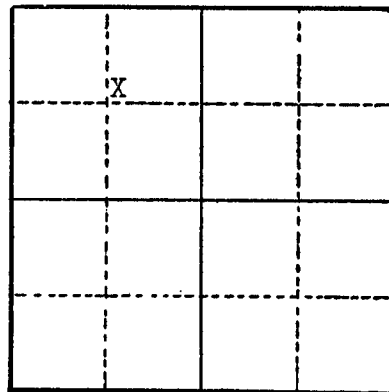

Section 5

Altitude at well

TYPE OF WELL: Drilled Date Constructed July, 1943

Depth drilled 33 feet Depth cased 33 feet

CASING RECORD:

2 inch steel casing set to 33 feet

FINISH:

Screen from 32 to 33 feet

AQUIFERS:

WATER LEVEL:

14 feet below surface

PUMPING EQUIPMENT: Type 2" centrifugal H.P. 2

Capacity 100 G.P.M.

WELL TESTS:

Drawdown ft. after hours G.P.M.

Drawdown ft. after hours G.P.M.

USE OF WATER Irrigation Temp. °F, 19

SOURCE OF INFORMATION Well Registration Statement

DRILLER or DIGGER

ADDITIONAL DATA:

Log Water Level Measurements Chemical Analysis Aquifer Test

REMARKS: