

STATE ENGINEER
Salem, Oregon

LINN
10521

LINN 10521
WELL RECORD

STATE WELL NO. 12/4N-5C
COUNTY LINN
APPLICATION NO. GR-2555

OWNER: John H. Mayne


MAILING ADDRESS: Rt. 4, Box 343-A

LOCATION OF WELL: Owner's No.

CITY AND STATE: Corvallis, Oregon

NE 1/4 NW 1/4 Sec. 5 T. 12 S, R. 4 W., W.M.

Bearing and distance from section or subdivision corner 1100' S. & 250' W.

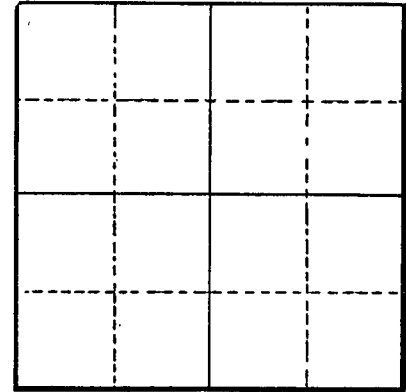

Section

Altitude at well

TYPE OF WELL: Drilled Date Constructed 1944

Depth drilled 23 Depth cased 23

CASING RECORD:

5-inch

FINISH:

Open end casing

AQUIFERS:

Topsoil, sand and gravel

WATER LEVEL:

11-feet

PUMPING EQUIPMENT: Type Co-op Pump Centrifugal Capacity 30 G.P.M.

H.P. 1

WELL TESTS:

Drawdown ft. after hours G.P.M.
Drawdown ft. after hours G.P.M.

USE OF WATER Irrigation Temp. °F., 19

SOURCE OF INFORMATION GR-2414

DRILLER or DIGGER

ADDITIONAL DATA:

Log X Water Level Measurements Chemical Analysis Aquifer Test

REMARKS:

Topsoil 6
Ocean Beach sand 10
Gravel 7