

STATE ENGINEER
Salem, Oregon

LINN
10525


LINN 10525
Well Record

STATE WELL NO. 12/4W-5P
COUNTY LINN
APPLICATION NO. GR-1642

OWNER: Paul R. Elliker & Anne R. Elliker MAILING ADDRESS: Box 347, Route 4
CITY AND STATE: Corvallis, Oregon

LOCATION OF WELL: Owner's No. #2
SE 1/4 SW 1/4 Sec. 5 T. 12 S., R. 4 W., W.M.

Bearing and distance from section or subdivision corner 840' N. and 1290' E.

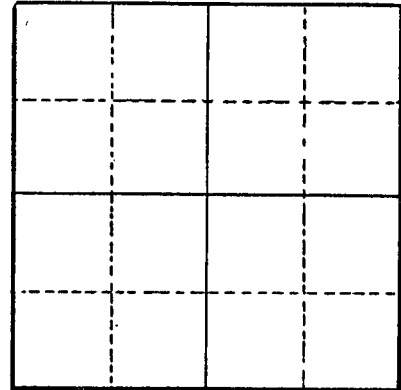

Section

Altitude at well

TYPE OF WELL: Drilled Date Constructed 1947 or 1948

Depth drilled 100 Depth cased 100

CASING RECORD:

6-inch

FINISH:

AQUIFERS:

Dirt and clay and sand and gravel

WATER LEVEL:

15-feet

PUMPING EQUIPMENT: Type H.P.

Capacity G.P.M.

WELL TESTS:

Drawdown ft. after hours G.P.M.

Drawdown ft. after hours G.P.M.

USE OF WATER Irrigation Temp. °F., 19.

SOURCE OF INFORMATION GR-2256

DRILLER or DIGGER

ADDITIONAL DATA:

Log Water Level Measurements Chemical Analysis Aquifer Test

REMARKS:

Dirt and clay 12 100
Sand and gravel 88 100