

STATE ENGINEER
Salem, Oregon


LINN 10526 **Well Record**

STATE WELL NO. 12/4W - 5J
COUNTY LINN
APPLICATION NO. GR-2207

OWNER: Charles and Beulah Hindes, or their survivors
MAILING ADDRESS: Rt. 3, Box 797
CITY AND STATE: Albany, Oregon

LOCATION OF WELL: Owner's No. _____
NE 1/4 SE 1/4 Sec. 5 T. 12 S., R. 4 W., W.M.

Bearing and distance from section or subdivision corner 1980' N. and 264' W.

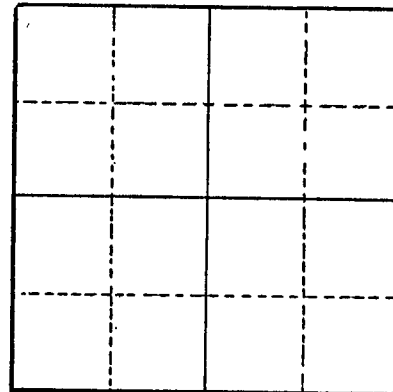

Section _____

Altitude at well _____

TYPE OF WELL: Drilled Date Constructed 1952

Depth drilled 35 Depth cased 35

CASING RECORD:

6-Inch

FINISH:

Perforations from 25 to 35

AQUIFERS:

WATER LEVEL:

5-Feet

PUMPING EQUIPMENT: Type Fairbanks Morse Turbine H.P. 15
Capacity 250 G.P.M.

WELL TESTS:

Drawdown _____ ft. after _____ hours _____ G.P.M.
Drawdown _____ ft. after _____ hours _____ G.P.M.

USE OF WATER Irrigation Temp. _____ °F., 19

SOURCE OF INFORMATION GR-2112

DRILLER or DIGGER _____

ADDITIONAL DATA:

Log _____ Water Level Measurements _____ Chemical Analysis _____ Aquifer Test _____

REMARKS: