


LINN
10527

OWNER: Paul R. Elliker & Anne R. Elliker MAILING ADDRESS: Box 347, Route 4

LOCATION OF WELL: Owner's No. #1 CITY AND STATE: Corvallis, Oregon

SW 1/4 SW 1/4 Sec. 5 T. 12 N S, R. 4 W, W.M.

Bearing and distance from section or subdivision corner 690' N. and 210' E.

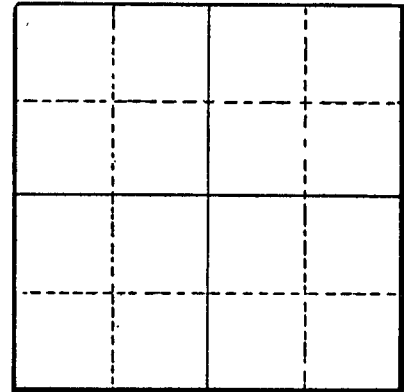

Section

Altitude at well

TYPE OF WELL: Drilled Date Constructed 1947

Depth drilled 38 Depth cased 38

CASING RECORD:

8-inch

FINISH:

AQUIFERS:

Dirt, clay, sand and gravel

WATER LEVEL:

15-feet

PUMPING EQUIPMENT: Type H.P.
Capacity G.P.M.

WELL TESTS:

Drawdown ft. after hours G.P.M.
Drawdown ft. after hours G.P.M.

USE OF WATER Irrigation Temp. °F., 19

SOURCE OF INFORMATION GR-2255

DRILLER or DIGGER

ADDITIONAL DATA:

Log Water Level Measurements Chemical Analysis Aquifer Test

REMARKS:

Dirt and clay 12 38
Sand and gravel 26 38