

STATE ENGINEER
Salem, Oregon

LINN
10562

OBSERVATION WELL
Well Record

STATE WELL NO. 12/3W-29P(1)
COUNTY Linn
APPLICATION NOGR-563

OWNER: R. L. & Rova Wirth

MAILING ADDRESS:

LOCATION OF WELL: Owner's No.


CITY AND STATE:

Tangent, Oregon

SE 1/4 SW 1/4 Sec. 29 T. 12 N. S. R. 3 E. W.M.

Bearing and distance from section or subdivision

corner N. 32° 10' W. 9 chs. from SE cor. SW 1/4 Sec. 29

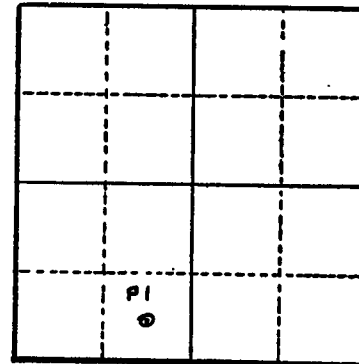

Section 29

Altitude at well 250 ft.

TYPE OF WELL: drilled Date Constructed May 1952

Depth drilled 106 ft. Depth cased 106 ft.

CASING RECORD: 10 inch

FINISH: Perforated 40 to 70 ft.
98 to 103 ft.

AQUIFERS:

WATER LEVEL: 30 ft.

PUMPING EQUIPMENT: Type Berkeley turbine H.P. 10
Capacity 400 G.P.M.

WELL TESTS:
Drawdown 50 ft. after 280 hours G.P.M.
Drawdown ft. after hours G.P.M.

USE OF WATER irrigation 31 acres Temp. °F. 19

SOURCE OF INFORMATION GR-563

DRILLER or DIGGER Raymond Gellately; Philomath, Oregon

ADDITIONAL DATA:

Log Water Level Measurements Chemical Analysis Aquifer Test

REMARKS:

