

STATE ENGINEER  
Salem, Oregon

LINN  
10585

LINN 10585  
Well Record

STATE WELL NO. 12/4W-6B  
COUNTY LINN  
APPLICATION NO. GR-3723

OWNER: J. L. Hovey


MAILING ADDRESS: Rt 4 Box 328

LOCATION OF WELL: Owner's No.

CITY AND STATE: Corvallis, Oregon

NE NW 1/4 NE 1/4 Sec. 6 T. 12 S., R. 4 W., W.M.

Bearing and distance from section or subdivision corner 2 miles E of Corvallis, Oregon

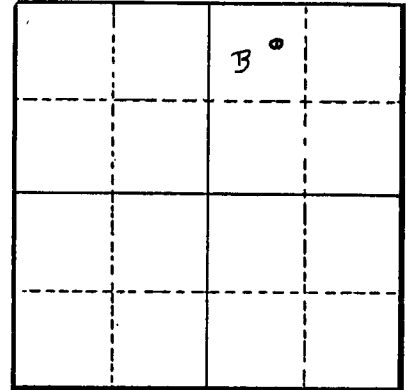

Section 6

Altitude at well

TYPE OF WELL: Drilled Date Constructed 1952

Depth drilled 39' Depth cased 35'

CASING RECORD:

8-inch

FINISH:

AQUIFERS:

WATER LEVEL: 15'

PUMPING EQUIPMENT: Type Fairbanks Morse Pomona Turbine H.P. 5

Capacity 150 G.P.M.

WELL TESTS:

Drawdown 14 ft. after 300 hours G.P.M.

Drawdown ft. after hours G.P.M.

USE OF WATER Irrigation Temp. °F., 19

SOURCE OF INFORMATION GR-3922

DRILLER or DIGGER C. A. Shafer

ADDITIONAL DATA:

Log NA Water Level Measurements Chemical Analysis Aquifer Test

REMARKS: