

LINN
10586

OWNER: Fred C. & Dora E. Meyers


MAILING ADDRESS: 1110 N. 3rd St.

LOCATION OF WELL: Owner's No.

CITY AND STATE: Corvallis, Oregon

SW 1/4 NW 1/4 Sec. 6 T. 12 S., R. 4 W., W.M.

Bearing and distance from section or subdivision corner S. 21 1/2 30' E. 1600 ft. from NW cor. Sec. 6

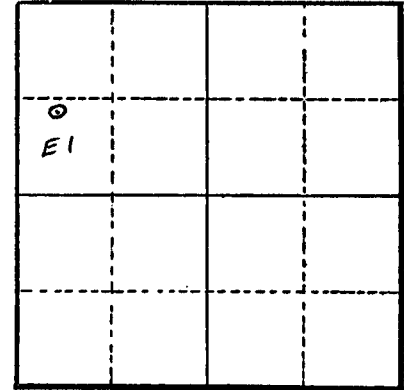

Section 6

Altitude at well 215 ft.

TYPE OF WELL: drilled Date Constructed June 1954

Depth drilled 34 ft. Depth cased

CASING RECORD: 6 in. steel 0 to 34 ft.

FINISH: Slot perforations 30 to 34 ft.

AQUIFERS:

WATER LEVEL: 15 ft.

PUMPING EQUIPMENT: Type Fairbanks Morse 2" centrifugal H.P. 10 elec.
Capacity 200 G.P.M.

WELL TESTS:
Drawdown 10 ft. after hours 150 G.P.M.
Drawdown ft. after hours G.P.M.

USE OF WATER irrigation Temp. °F. 19

SOURCE OF INFORMATION owner

DRILLER or DIGGER Gilbert Pruett; Rt. 4, Corvallis, Oregon

ADDITIONAL DATA:
Log Water Level Measurements Chemical Analysis Aquifer Test

REMARKS: