

STATE ENGINEER
Salem, Oregon

LINN
10597

Well Record

STATE WELL NO. 12/4W-6P(1)
COUNTY Linn
APPLICATION NO. GR-400

OWNER: Willard A. & Betty Hamlin


MAILING ADDRESS: Rt. 4, Box 362 A

LOCATION OF WELL: Owner's No.

CITY AND STATE: Corvallis, Oregon

SE 1/4 SW 1/4 Sec. 6 T. 12 N. S. R. 4 E. W., W.M.

Bearing and distance from section or subdivision corner N. 69° 55' E. 31.97 chs. from SW cor. Sec. 6

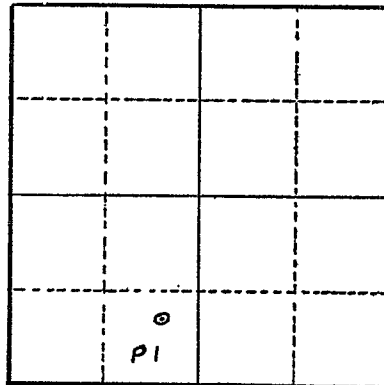

Altitude at well 220.8 ft.

TYPE OF WELL: drilled Date Constructed 10/14/44

Depth drilled 30 ft. Depth cased 30 ft.

Section 6

CASING RECORD: 10 inch

FINISH:

AQUIFERS:

WATER LEVEL: 10 ft.

PUMPING EQUIPMENT: Type Fairbanks Morse 4" centrifugal H.P. 15
Capacity 450 G.P.M.

WELL TESTS:

Drawdown ft. after hours G.P.M.

Drawdown ft. after hours G.P.M.

USE OF WATER irrigation 49 acres Temp. °F. 19

SOURCE OF INFORMATION GR-400

DRILLER or DIGGER Claude Shafer; Corvallis, Oregon

ADDITIONAL DATA:

Log Water Level Measurements Chemical Analysis Aquifer Test

REMARKS: