

STATE ENGINEER  
Salem, Oregon

LINN  
10613

# Well Record

STATE WELL NO. 12/LW-7B(1)  
COUNTY Linn  
APPLICATION NO. GR-484

OWNER: Walter V. & Edith Harrison


MAILING ADDRESS: Rt. 4, Box 360

LOCATION OF WELL: Owner's No. 1

CITY AND STATE: Corvallis, Oregon

NW 1/4 NE 1/4 Sec. 7 T. 12 S., R. 4 W., W.M.

Bearing and distance from section or subdivision corner S. 70° 35' E. 3455.23 ft. from NW cor. Sec. 7

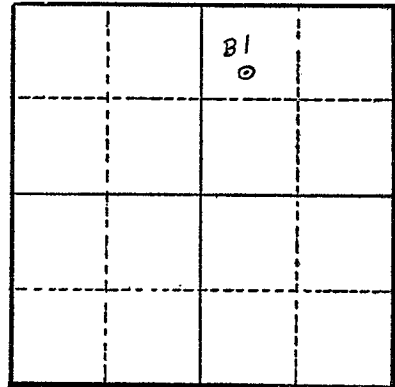

Section 7

Altitude at well 219.5 ft.

TYPE OF WELL: drilled Date Constructed 8/5/45

Depth drilled 31 ft. Depth cased 31 ft.

CASING RECORD: 10 inch

FINISH:

AQUIFERS:

WATER LEVEL: 20 inch

PUMPING EQUIPMENT: Type Pacific High Pressure H.P. 1  
Capacity 20 G.P.M.

WELL TESTS:  
Drawdown 3 ft. after \_\_\_\_\_ hours 200 G.P.M.  
Drawdown \_\_\_\_\_ ft. after \_\_\_\_\_ hours \_\_\_\_\_ G.P.M.

USE OF WATER domestic-irrigation Temp. \_\_\_\_\_ °F. \_\_\_\_\_, 19

SOURCE OF INFORMATION GR-484

DRILLER or DIGGER Studebaker Bros.; Salem, Oregon

ADDITIONAL DATA:

Log \_\_\_\_\_ Water Level Measurements \_\_\_\_\_ Chemical Analysis \_\_\_\_\_ Aquifer Test \_\_\_\_\_

REMARKS: