

STATE ENGINEER  
Salem, Oregon

LINN  
10614

# Well Record

STATE WELL NO. 12/LW-7F(1)  
COUNTY Linn  
APPLICATION NO. GR-484

OWNER: Walter & Edith Harrison


MAILING ADDRESS: Rt. 4, Box 360

LOCATION OF WELL: Owner's No. 2

CITY AND STATE: Corvallis, Oregon

SE 1/4 NW 1/4 Sec. 7- T. 12 N. S., R. 4 W., W.M.

Bearing and distance from section or subdivision  
corner S. 56° 50' E. 3083.34 ft. from NW cor. Sec. 7

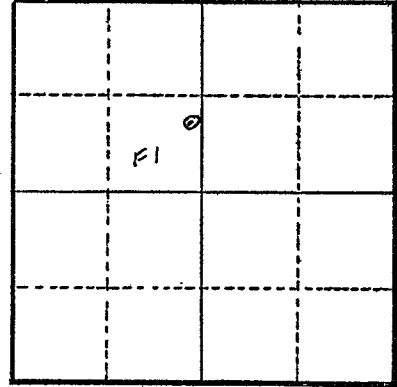

Section 7

Altitude at well 219 ft.

TYPE OF WELL: drilled Date Constructed 8/6/45

Depth drilled 31 ft. Depth cased 31 ft.

CASING RECORD: 10 inch

FINISH:

AQUIFERS:

WATER LEVEL: ?

PUMPING EQUIPMENT: Type Pacific centrifugal H.P. 15  
Capacity 350 G.P.M.

WELL TESTS:

Drawdown \_\_\_\_\_ ft. after \_\_\_\_\_ hours \_\_\_\_\_ G.P.M.

Drawdown \_\_\_\_\_ ft. after \_\_\_\_\_ hours \_\_\_\_\_ G.P.M.

USE OF WATER irrigation 43.5 acres Temp. \_\_\_\_\_ °F., 19

SOURCE OF INFORMATION GR-484

DRILLER or DIGGER Studebaker Bros.; Salem, Oregon

ADDITIONAL DATA:

Log <sup>X</sup> Water Level Measurements \_\_\_\_\_ Chemical Analysis \_\_\_\_\_ Aquifer Test \_\_\_\_\_

REMARKS: