

STATE ENGINEER
Salem, Oregon

LINN
10616

Well Record


STATE WELL NO. 12/LW-7F(2)
COUNTY Linn
APPLICATION NO. GR-484

OWNER: Walter & Edith Harrison
MAILING ADDRESS: Rt. 4, Box 360

LOCATION OF WELL: Owner's No. 3
CITY AND STATE: Corvallis, Oregon

SE 1/4 NW 1/4 Sec. 7 T. 12 N. S. R. 4 W., W.M.

Bearing and distance from section or subdivision corner S. 38° 46' E. 2584.18 ft. from NW cor. Sec. 7

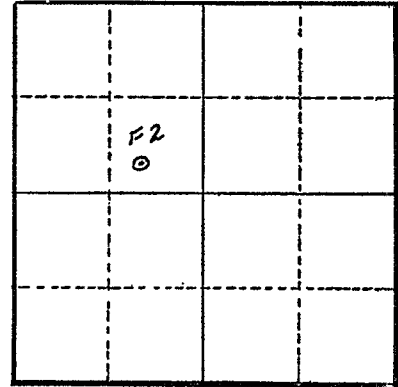

Section 7

Altitude at well 219 ft.

TYPE OF WELL: drilled Date Constructed 8/8/45

Depth drilled 31 ft. Depth cased 31 ft.

CASING RECORD: 10 inch

FINISH:

AQUIFERS:

WATER LEVEL: 20 ft.

PUMPING EQUIPMENT: Type Pacific centrifugal H.P. 15
Capacity 350 G.P.M.

WELL TESTS:
Drawdown 1 1/2 ft. after 600 hours G.P.M.
Drawdown ft. after hours G.P.M.

USE OF WATER irrigation 34.2 acres Temp. °F. 19

SOURCE OF INFORMATION GR-484
DRILLER or DIGGER Studebaker Bros.; Salem, Oregon

ADDITIONAL DATA:
Log Water Level Measurements Chemical Analysis Aquifer Test

REMARKS: