

STATE ENGINEER  
Salem, Oregon

LINN  
10617

# Well Record

STATE WELL NO. 12/4W-7G  
COUNTY LINN  
~~APPLICATION NO. GR-2451~~

OWNER: Louis W. and Zola Hamlin


MAILING ADDRESS: Rt. 4, Box 357 C.

LOCATION OF WELL: Owner's No. \_\_\_\_\_

CITY AND STATE: Corvallis, Oregon

SW 1/4 NE 1/4 Sec. 7 T. 12 S., R. 4 W., W.M.

Bearing and distance from section or subdivision corner 1947' S. and 2376' W.

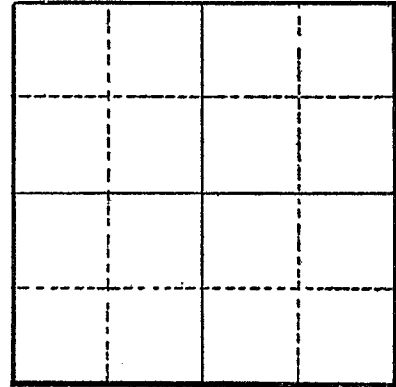

Section \_\_\_\_\_

Altitude at well \_\_\_\_\_

TYPE OF WELL: Drilled Date Constructed 1949

Depth drilled 33 Depth cased 33

### CASING RECORD:

10-inch

### FINISH:

Slot perforations from 27 to 33

### AQUIFERS:

### WATER LEVEL:

13-feet

PUMPING EQUIPMENT: Type Pacific Centrifugal H.P. 15  
Capacity 450 G.P.M.

### WELL TESTS:

Drawdown \_\_\_\_\_ ft. after \_\_\_\_\_ hours \_\_\_\_\_ G.P.M.  
Drawdown \_\_\_\_\_ ft. after \_\_\_\_\_ hours \_\_\_\_\_ G.P.M.

USE OF WATER Irrigation Temp. \_\_\_\_\_ °F., 19 \_\_\_\_\_

SOURCE OF INFORMATION GR-2323

DRILLER or DIGGER Slate Drilling Company, Tangent, Oregon

### ADDITIONAL DATA:

Log \_\_\_\_\_ Water Level Measurements \_\_\_\_\_ Chemical Analysis \_\_\_\_\_ Aquifer Test \_\_\_\_\_

### REMARKS: