

STATE ENGINEER
Salem, Oregon

LINN
10643

Well Record

STATE WELL NO. 12/4W-8C
COUNTY LINN
APPLICATION NO. GR-2671

OWNER: Irving S. and Hilda F. Harden


MAILING ADDRESS: Rt. 3, Box 803

LOCATION OF WELL: Owner's No.

CITY AND STATE: Albany, Oregon

NE 1/4 NW 1/4 Sec. 8 T. 12 S. R. 4 W., W.M.

Bearing and distance from section or subdivision corner 132' S. and 1782' E.

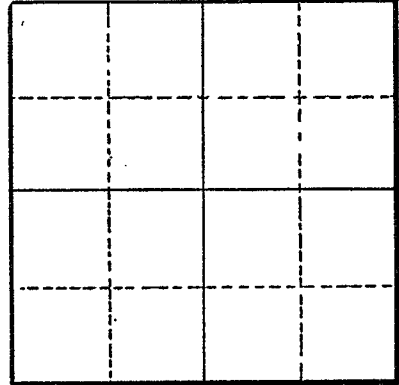

Section

Altitude at well

TYPE OF WELL: drilled Date Constructed 1938

Depth drilled 41 Depth cased 41

CASING RECORD:

4-inch

FINISH:

3" pipe within 4" casing from 37 to 41

AQUIFERS:

WATER LEVEL:

PUMPING EQUIPMENT: Type Denver Gardner Centrifugal H.P. 2
Capacity G.P.M.

WELL TESTS:

Drawdown ft. after hours G.P.M.
Drawdown ft. after hours G.P.M.

USE OF WATER irrigation Temp. °F., 19

SOURCE OF INFORMATION GR-2533

DRILLER or DIGGER W. A. Slate, Tangent, Oregon

ADDITIONAL DATA:

Log Water Level Measurements Chemical Analysis Aquifer Test

REMARKS: